


TOWNSHIP 34S, RANGE 4W, W. M.

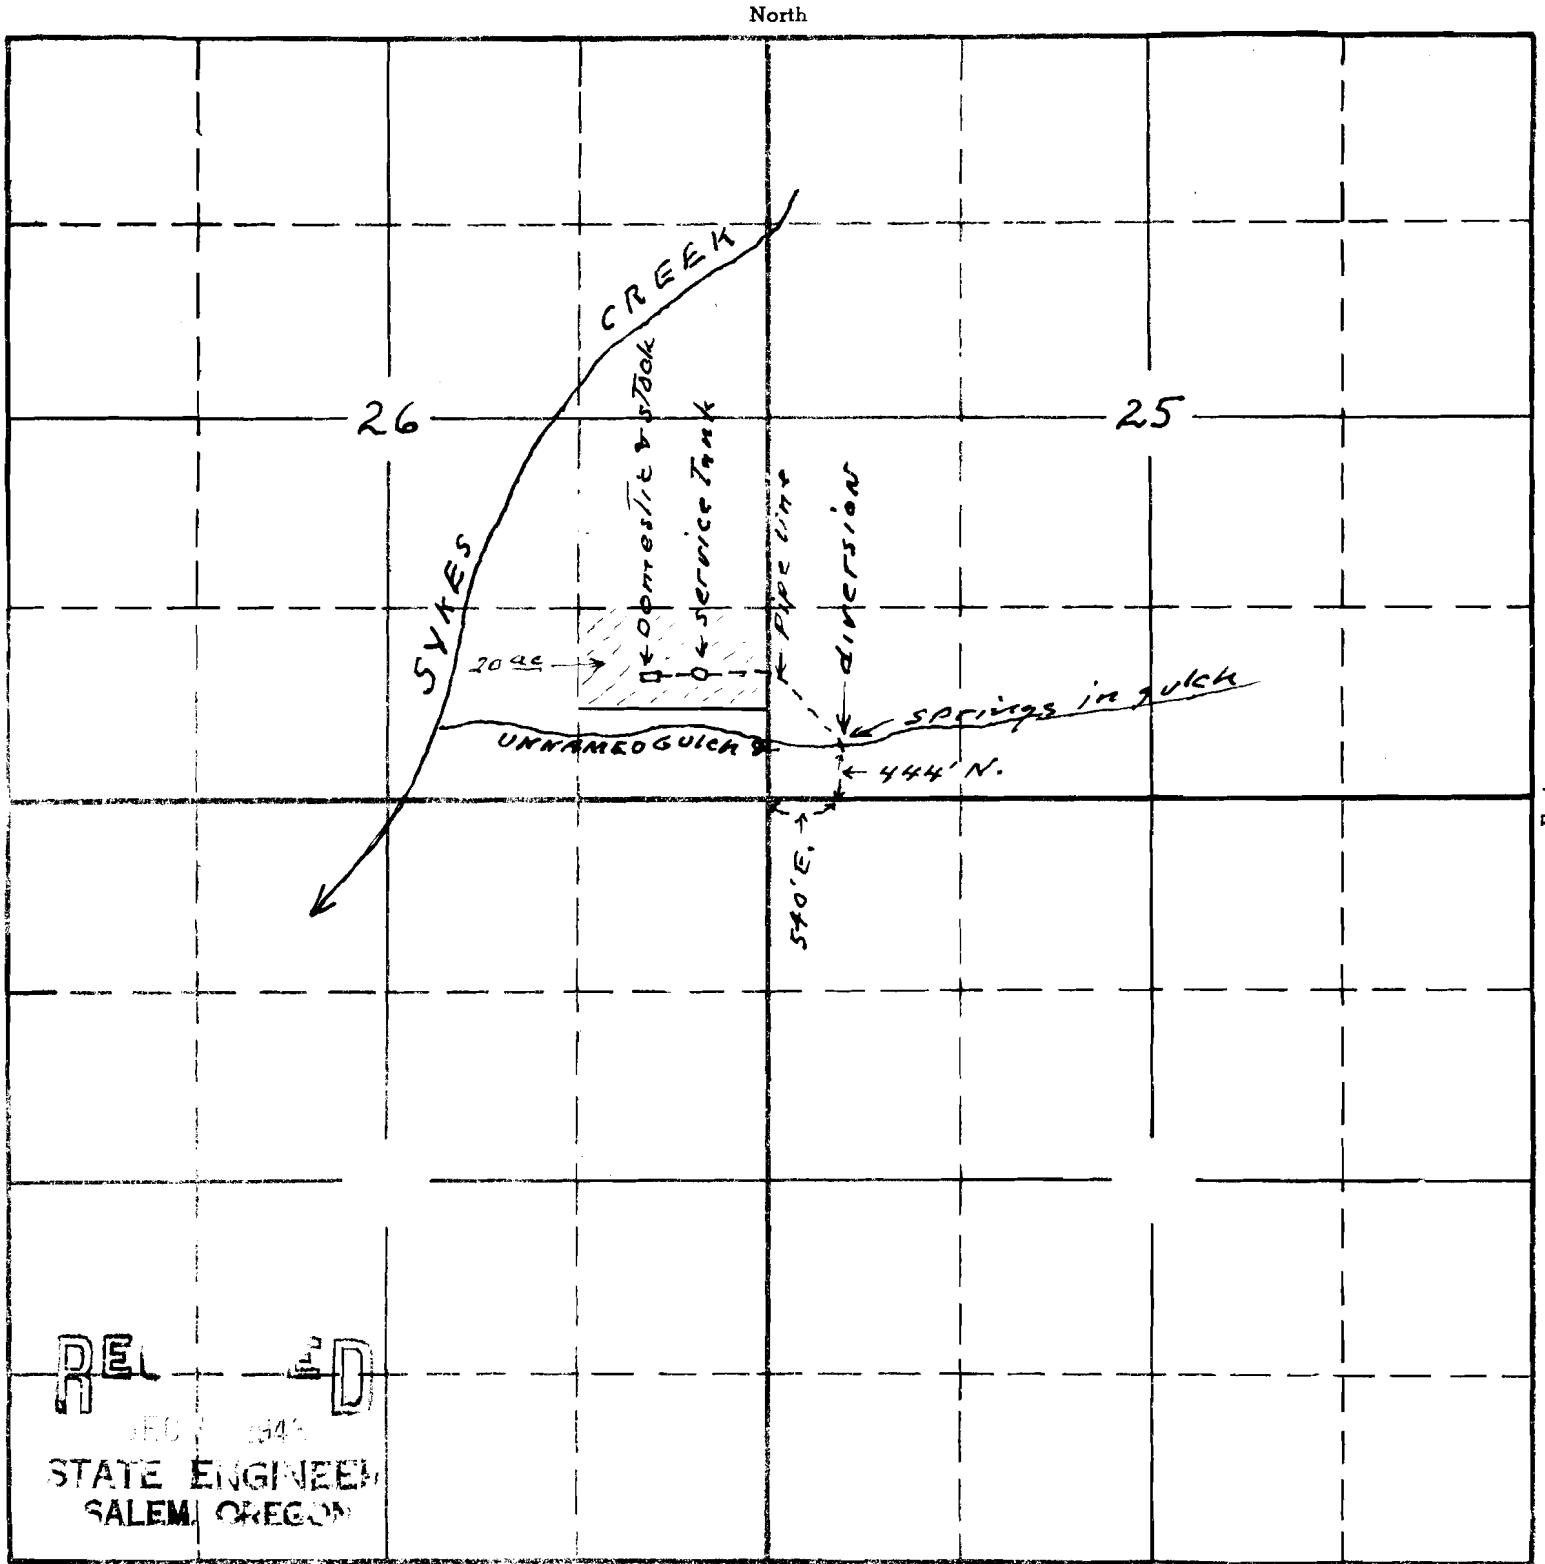

RECEIVED
 JUL 19 1945
 STATE ENGINEER
 SALEM, OREGON

Map to accompany application of
 James Carnegie Jr. for use of
 waters of unnamed gulch and
 Springs in said gulch for irrigation,
 domestic and stock purposes.

20094
 15655
 APPLICATION No. 20094
 PERMIT No. 15655

this office 11/10/43 *[Signature]*