


10

TOWNSHIP 33 S, RANGE 2 E, W. M.

North

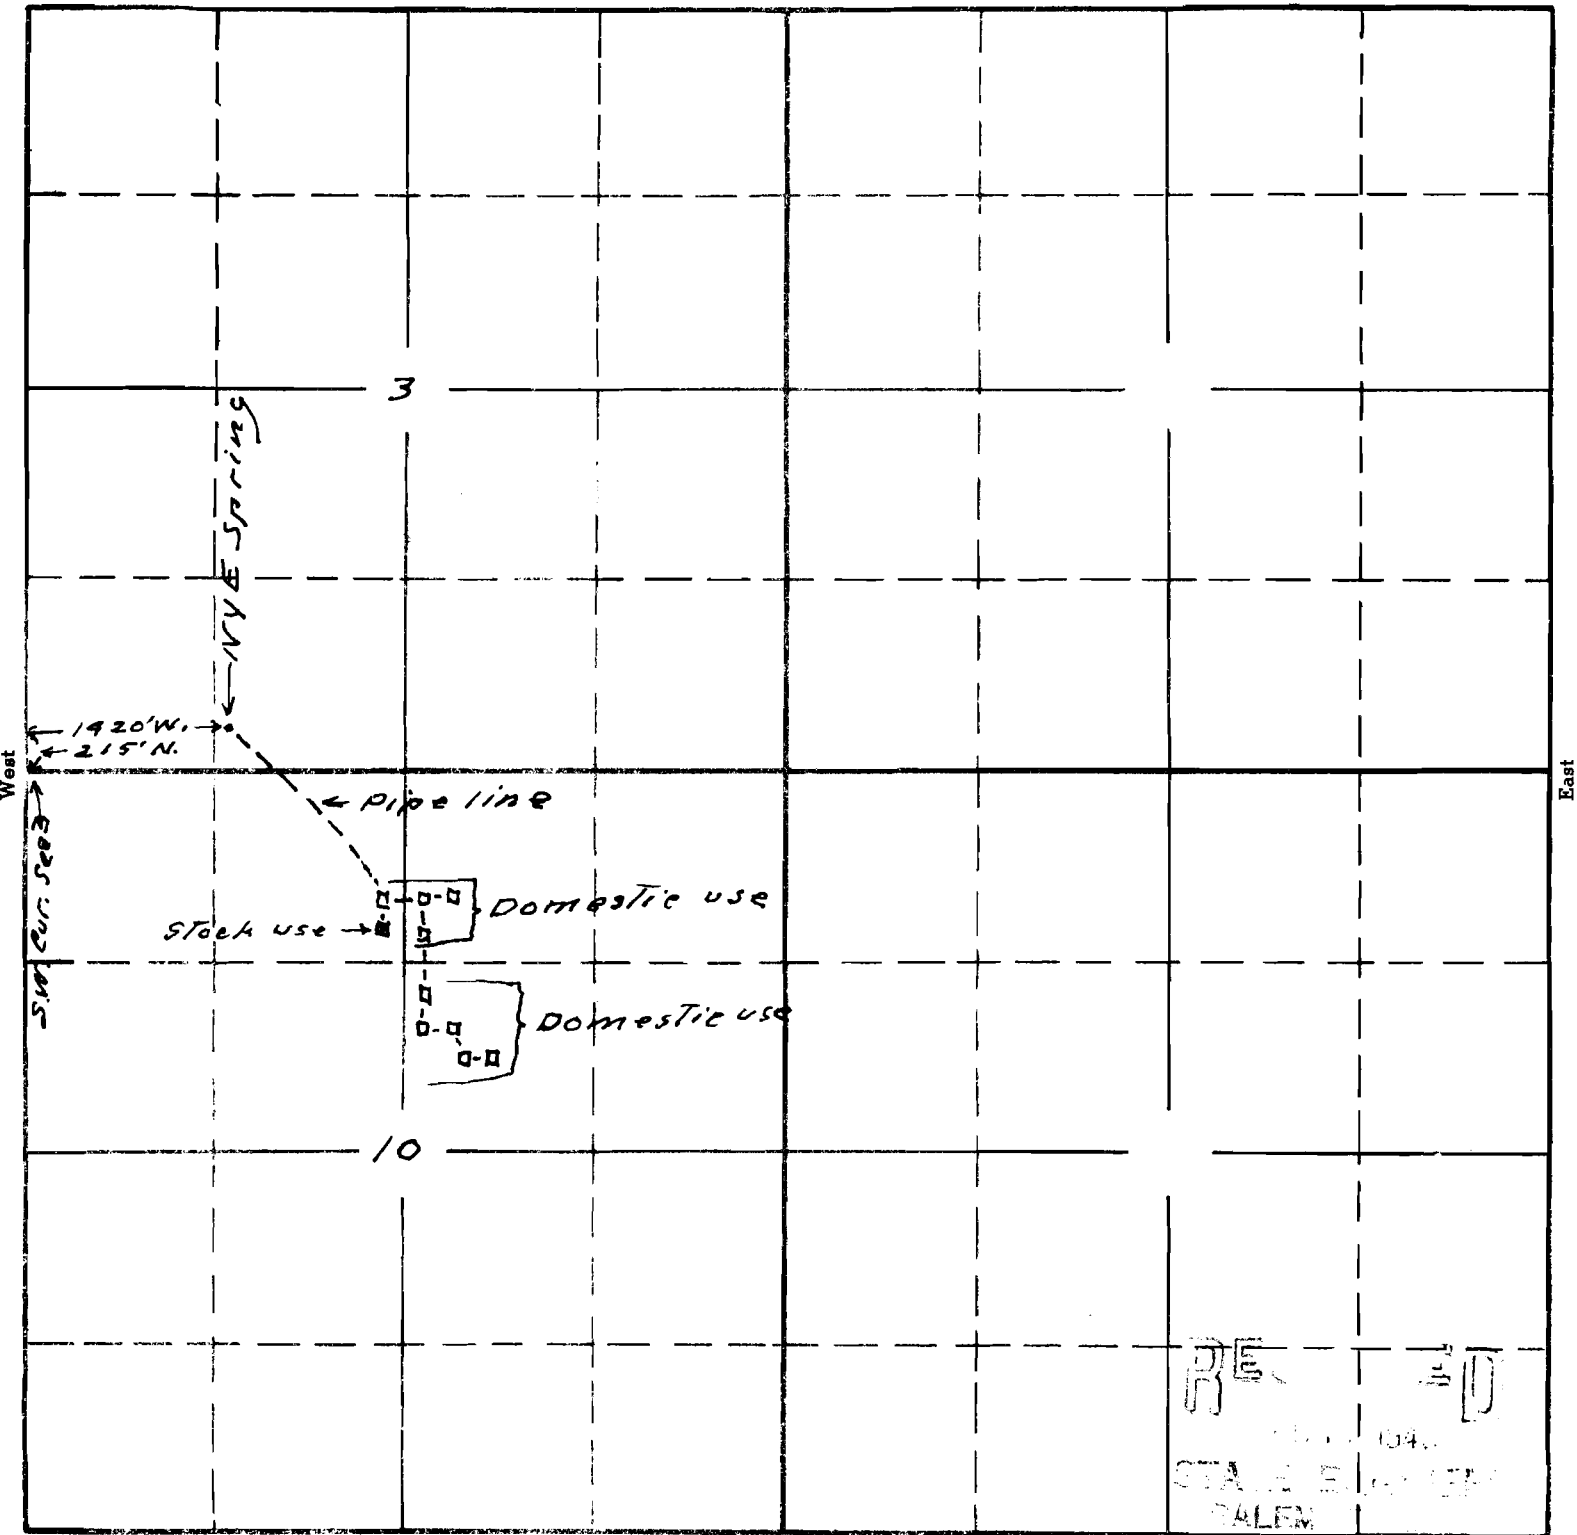

South

RECEIVED
 1943
 STATE ENGINEER
 OREGON

20100
 15660
 APPLICATION No. 20100
 PERMIT No. 15660

Sketch to accompany application of
 Nelson M & Clarice NYE for use of Nye
 Spring for domestic and stock use

This office 12/8/43 *[Signature]*