


18

TOWNSHIP 39 S, RANGE 4 W, W. M.

North

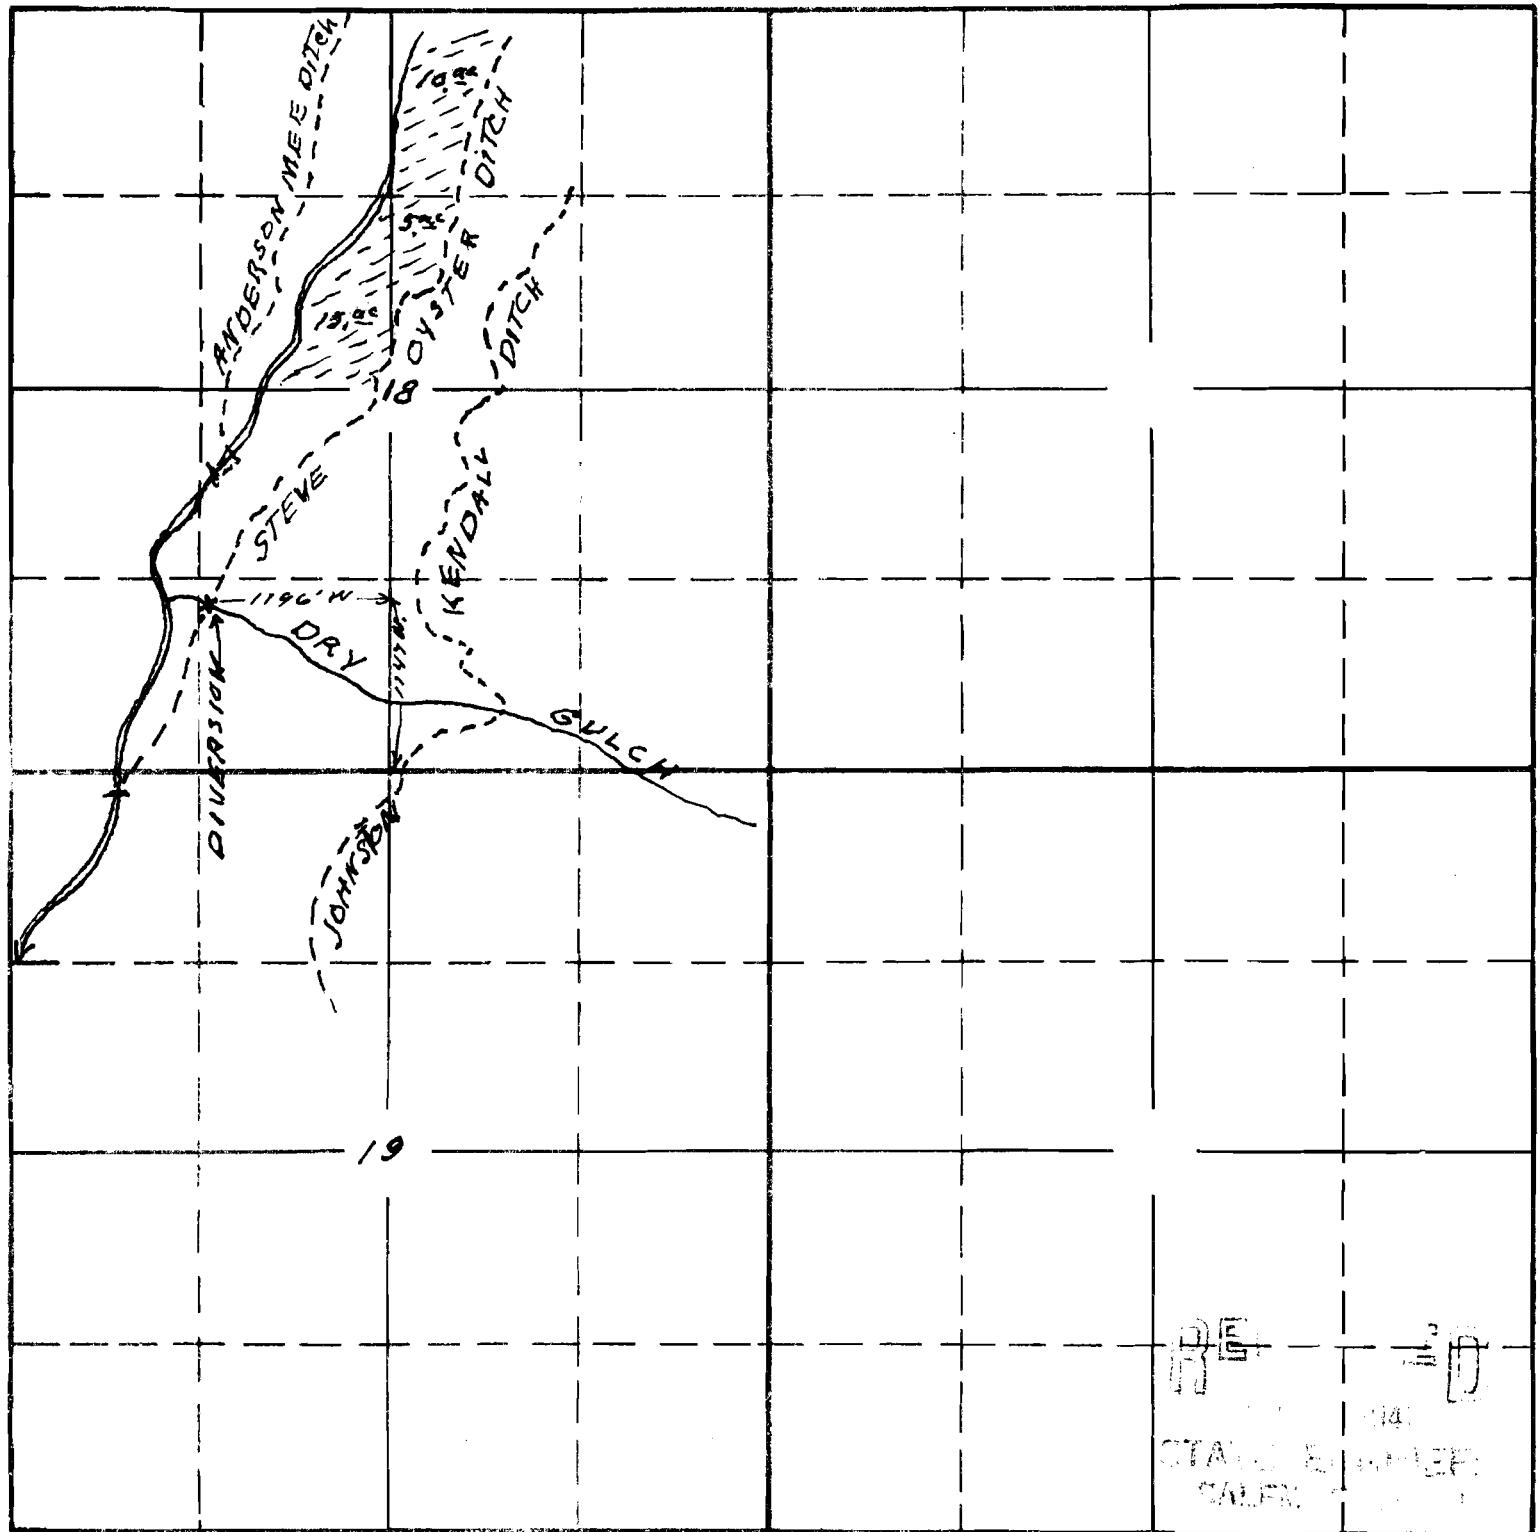

South

Sketch to accompany application of S.L. Johnson for use of seepage, runoff, accrued, and Dry Gulch waters arriving at diversion point where Dry Gulch intersects Steve Oyster Ditch for irrigation purposes.

RECEIVED
 STATE ENGINEER
 SALEM, OREGON

20101
 15-16-8
 APPLICATION No. 20101
 PERMIT No. 15661

This office 12/4/43 W. Smith