


Sec.

Tp. 4 / 5

R 8 W

Permit: S 15665
Volume: 8
Strm: E FK ILLINOIS R
Trib: ILLINOIS R
Priority: 12/20/43

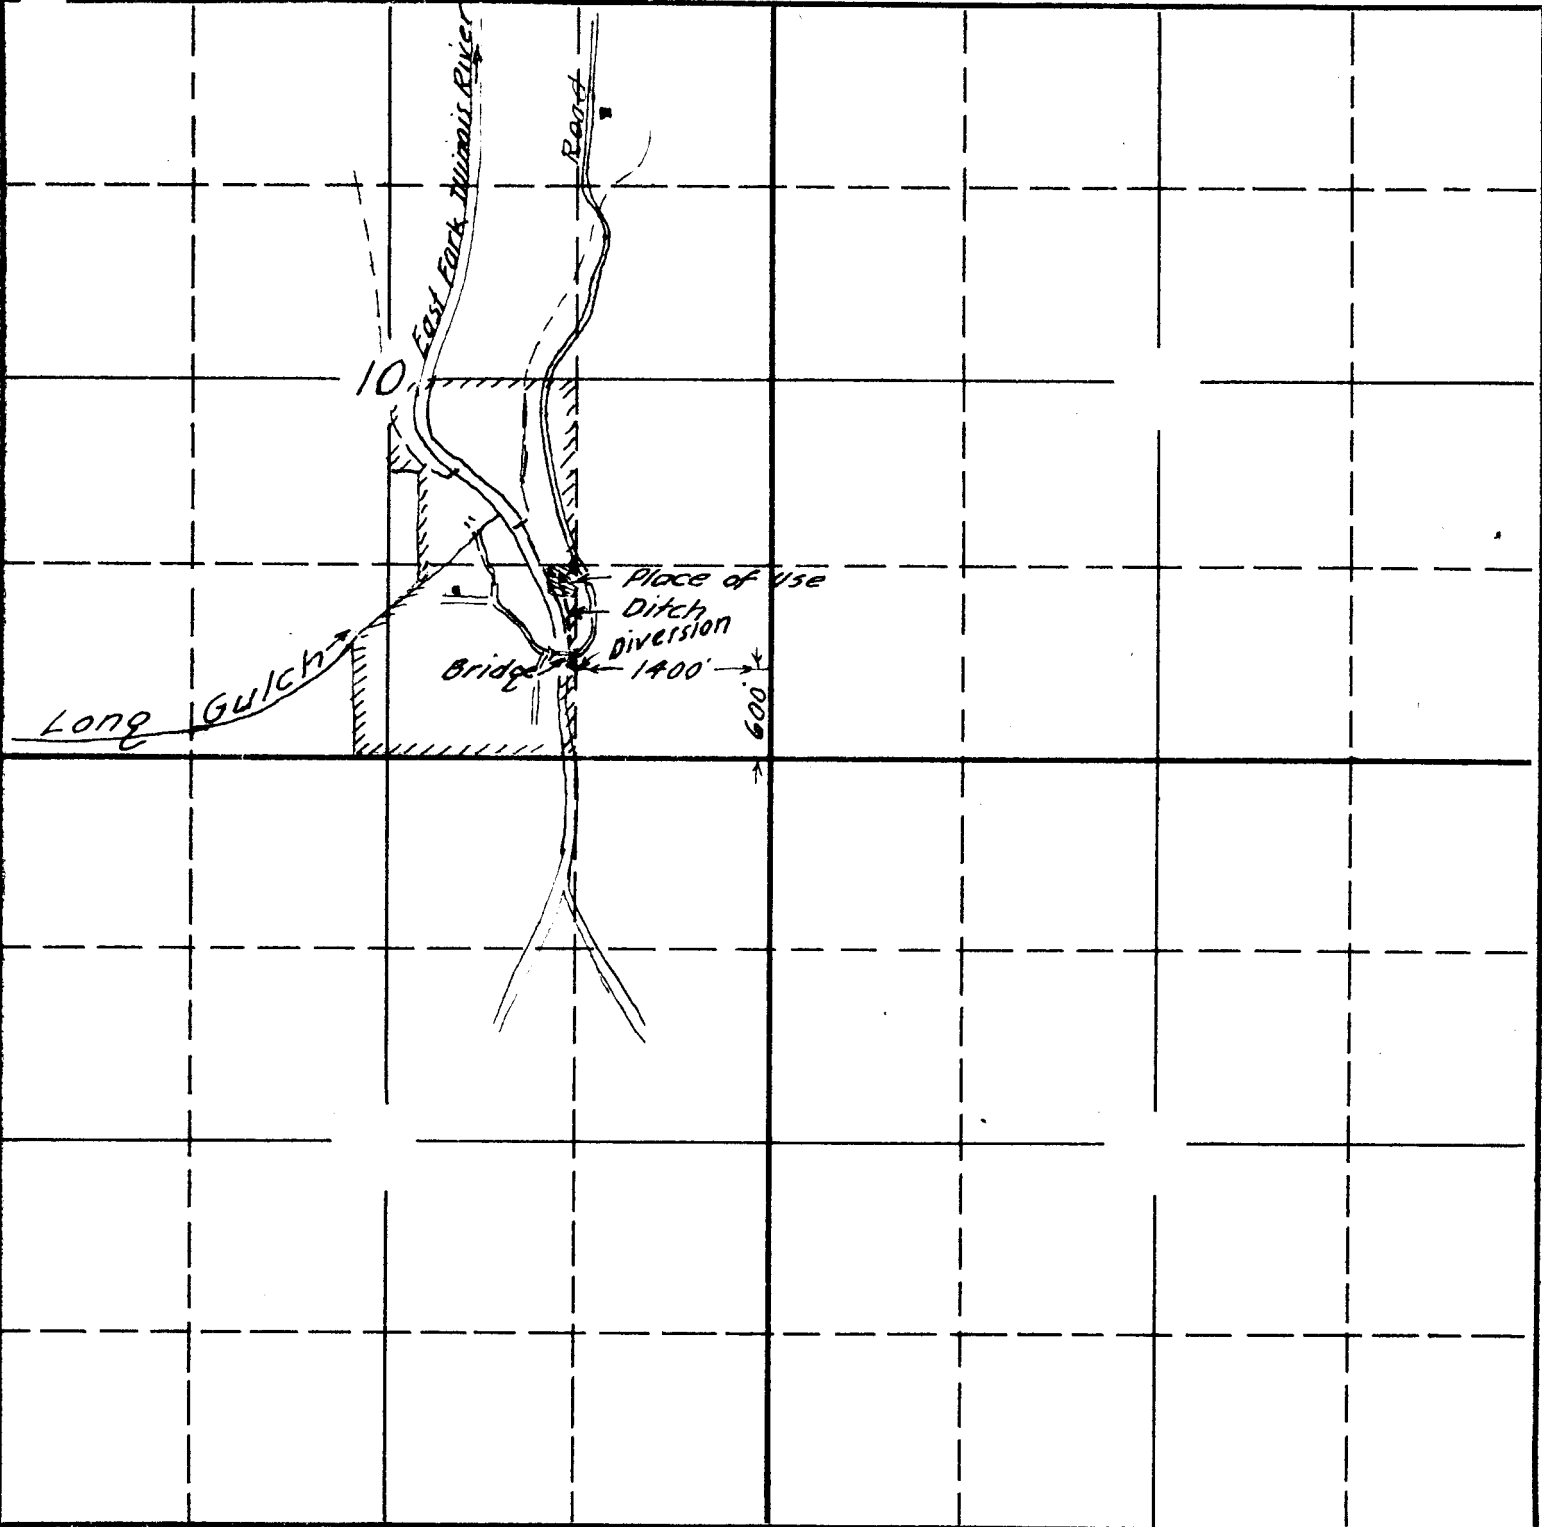

Ed N Basye
Dec. 1943.

20107
App'n No. 20107
Permit No. 15665