


20

TOWNSHIP 36S, RANGE 4W, W. M.

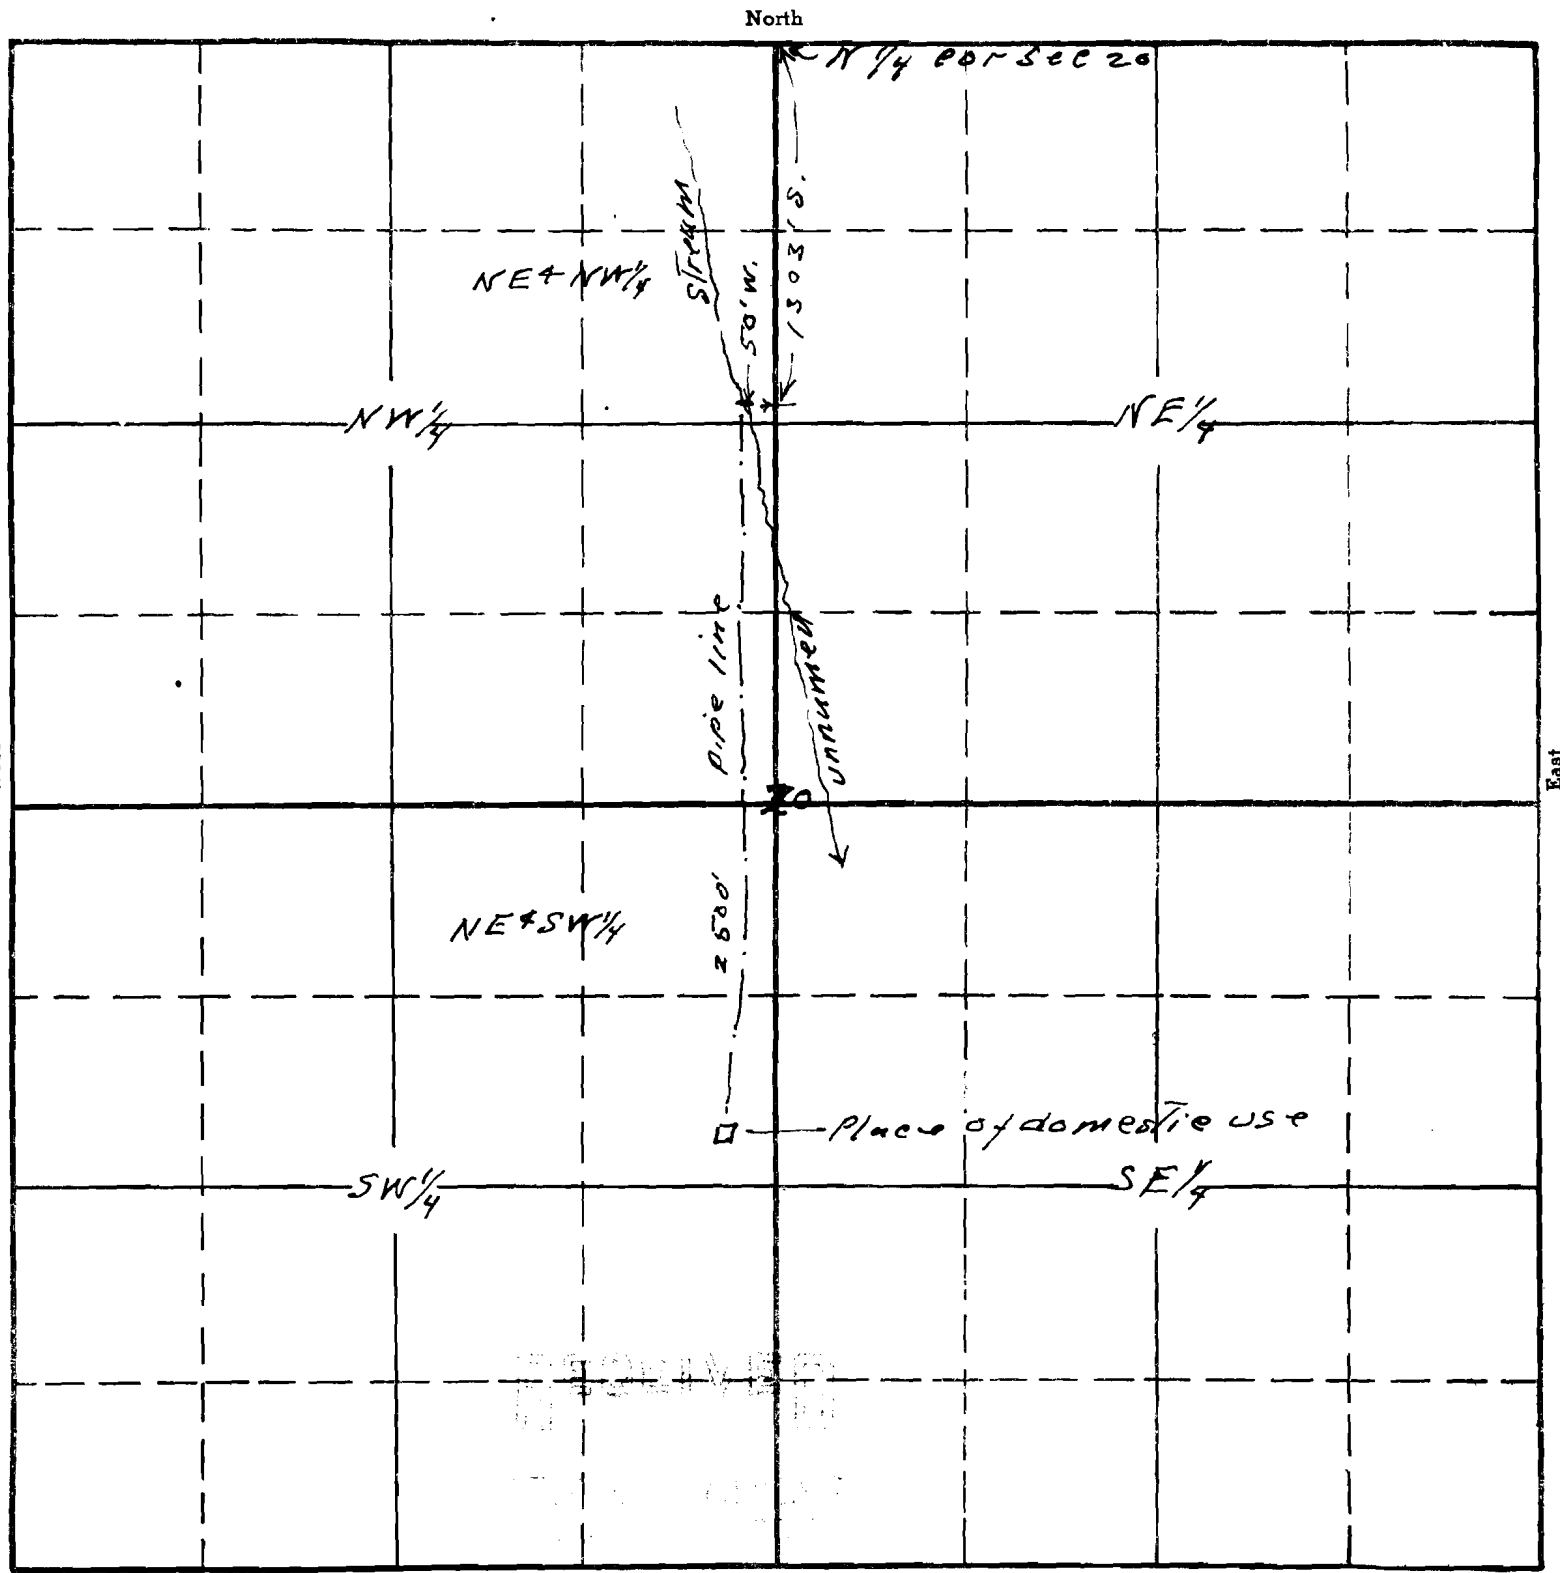

Corrected map to be a part of
 Permit 15668 in the name of
 Claud Palmer, showing the actual
 point of diversion and place of use,
 and correcting map and description
 as furnished with this permit

APPLICATION No. 20114
 PERMIT No. 15668