


SECTION

Lot 4
sec 35

TOWNSHIP 13 S, RANGE 10 W, W. M.

North

West

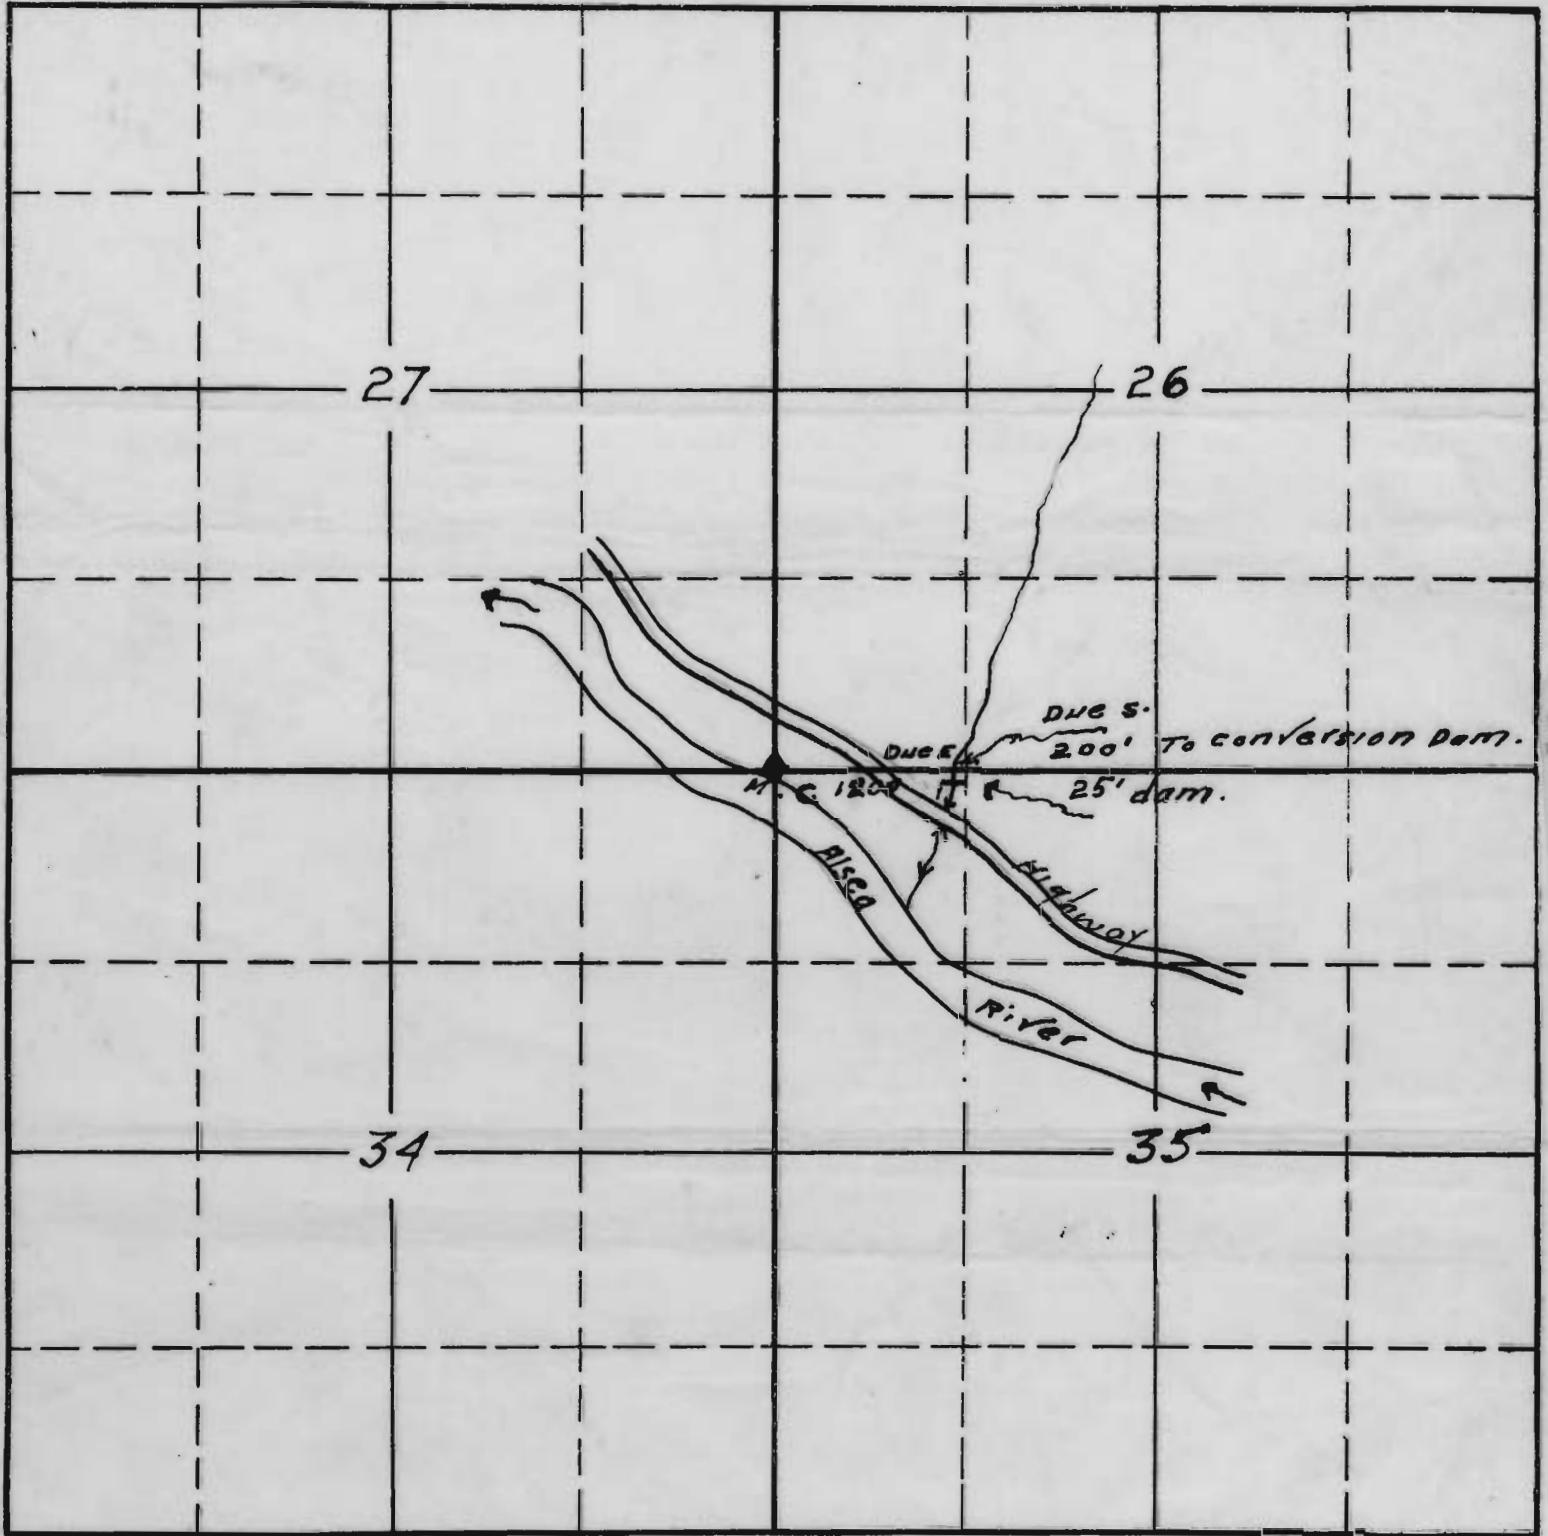

South

20143 OK
18-11

RECEIVED
FEB 23 1944
STATE ENGINEER
SALEM, OREGON

RECEIVED
FEB 29 1944
STATE ENGINEER
SALEM, OREGON

APPLICATION No. 15701
PERMIT No.