


T.5S. R.1W.W.M.

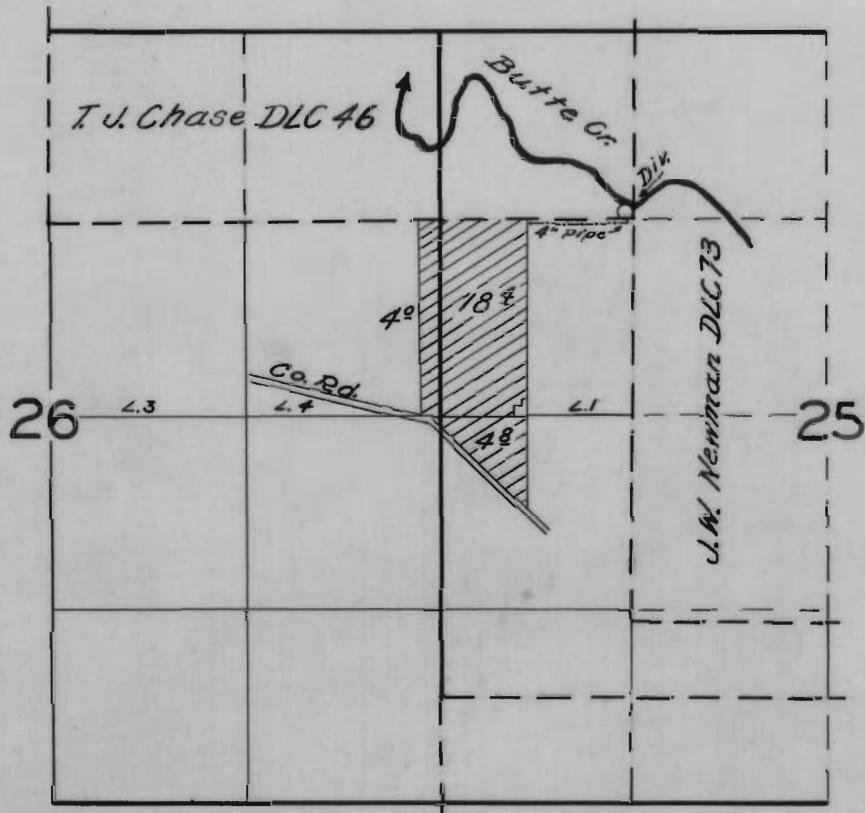

**FINAL PROOF SURVEY**

UNDER

Application No. 20170 Permit No. 15716

IN NAME OF

**IVER TWITO**

Surveyed April 1954, by H.L. Coffman