


10

TOWNSHIP 33 S, RANGE 2 E, W. M.

North

West

East

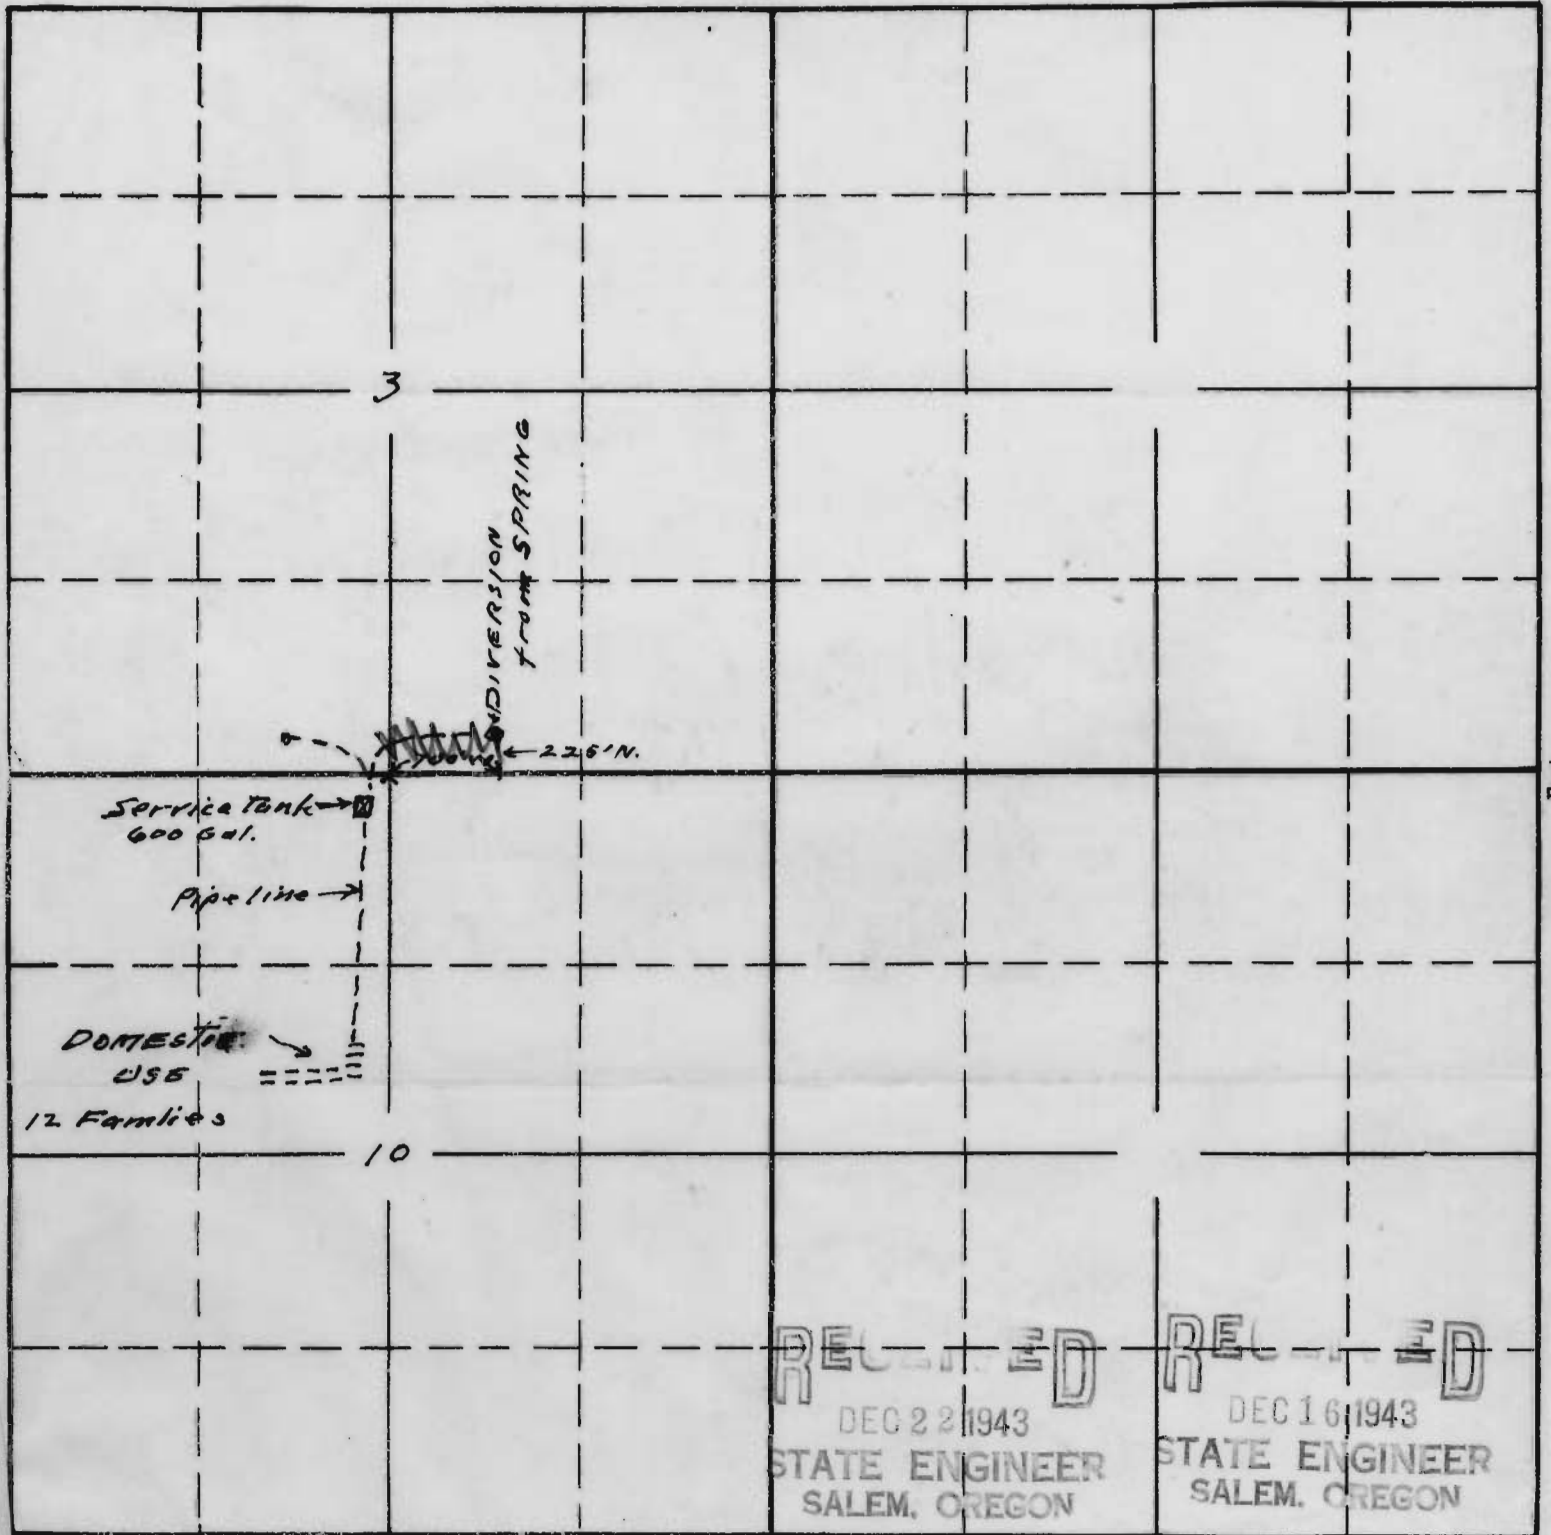

South

20105 OR  
15-78B

APPLICATION No.

PERMIT No. 15729

Map to accompany application of  
Geo L Santzer Lumber Co. Inc. for  
(2) domestic use from No. 1 Spring

This office 12/2/43 *Effinick*