


TOWNSHIP 39 S., RANGE 5 W.,

North

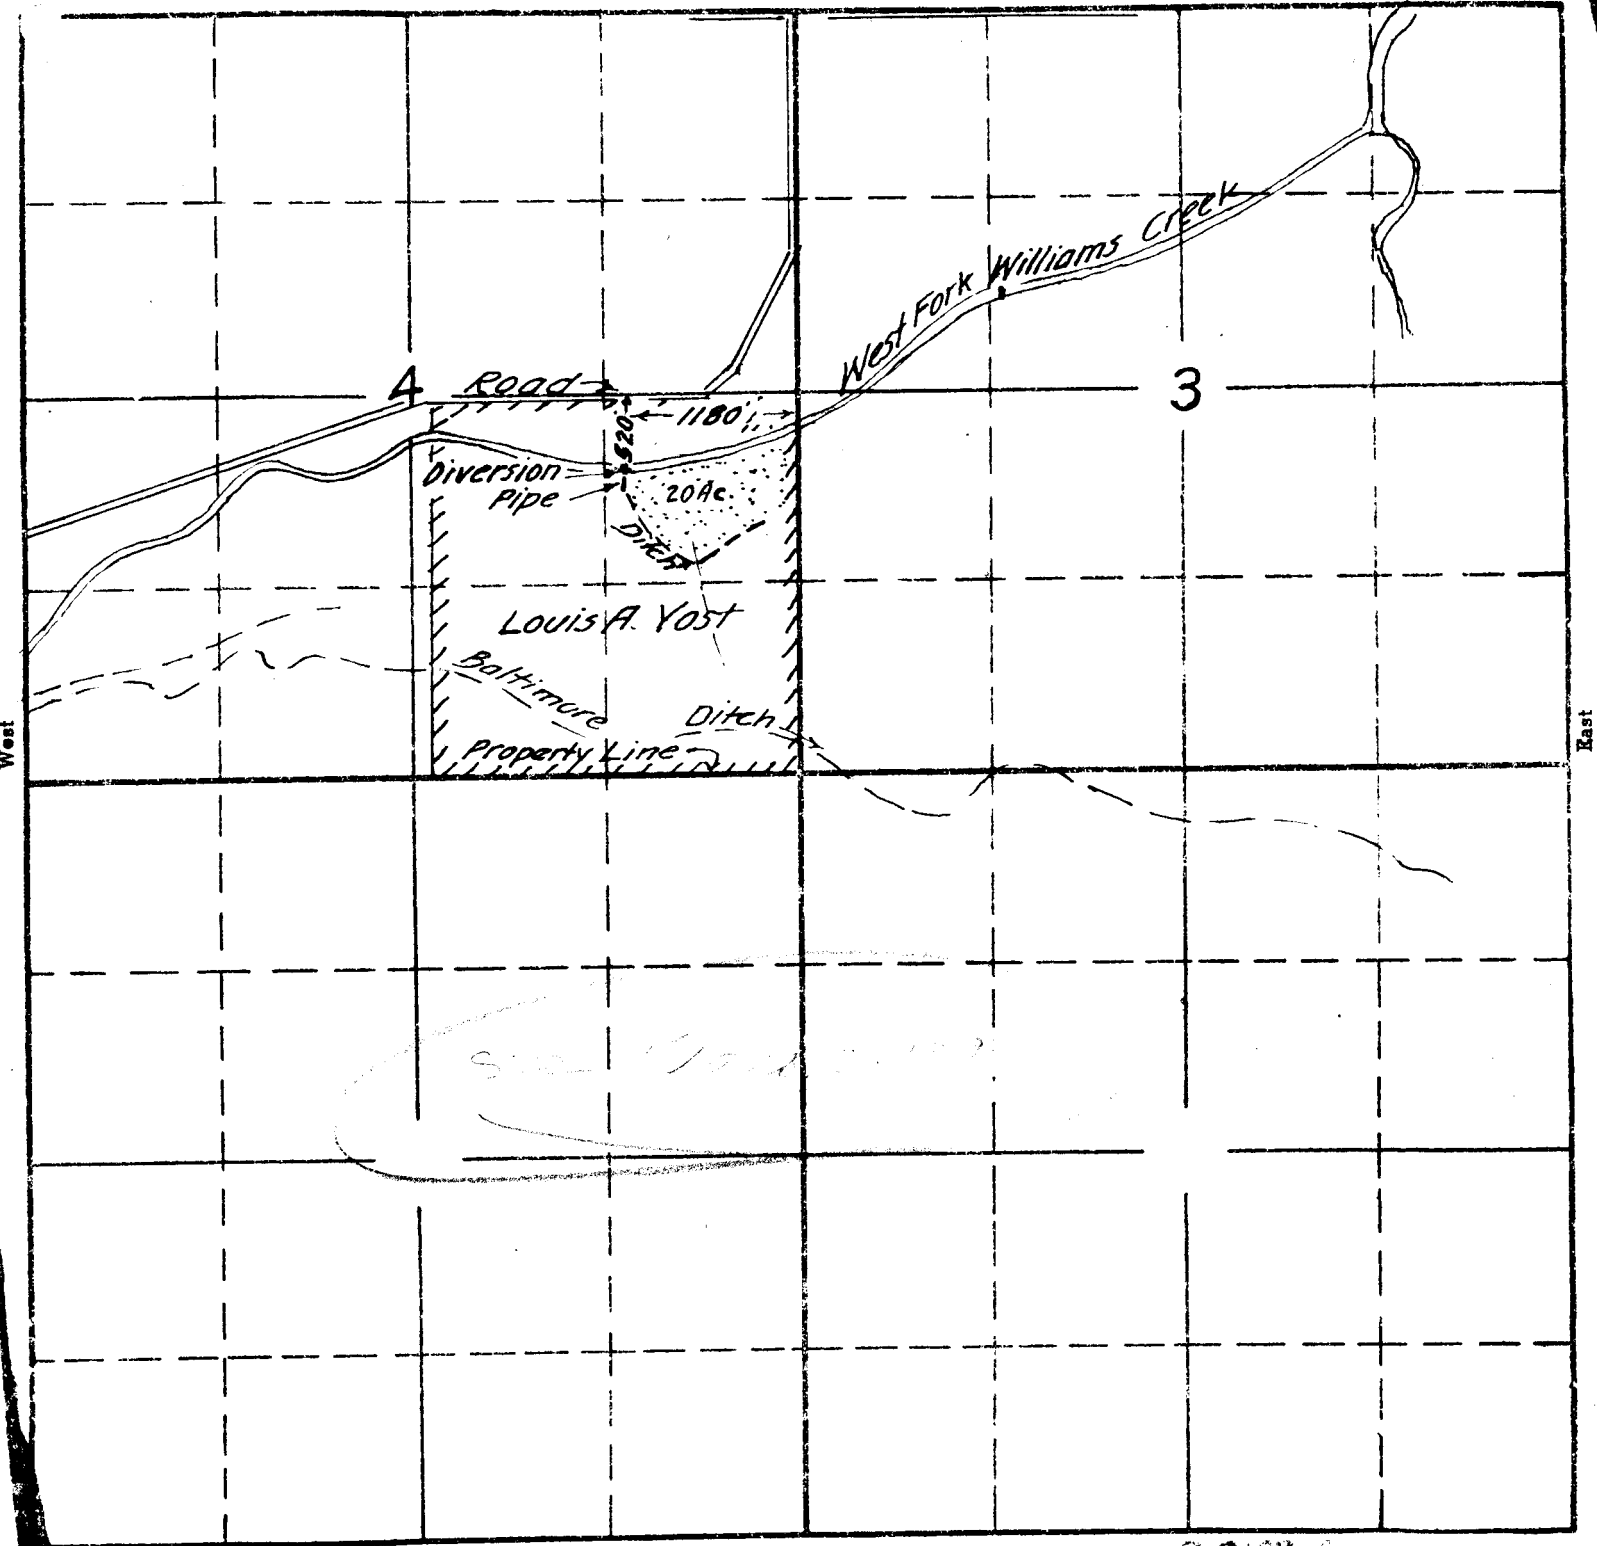


South



Louis A. Yost
Mor. 1944.

20189
APPLICATION No. 20189
PERMIT No. 15741

T.39S.,R.5W.,W.M.

25-4

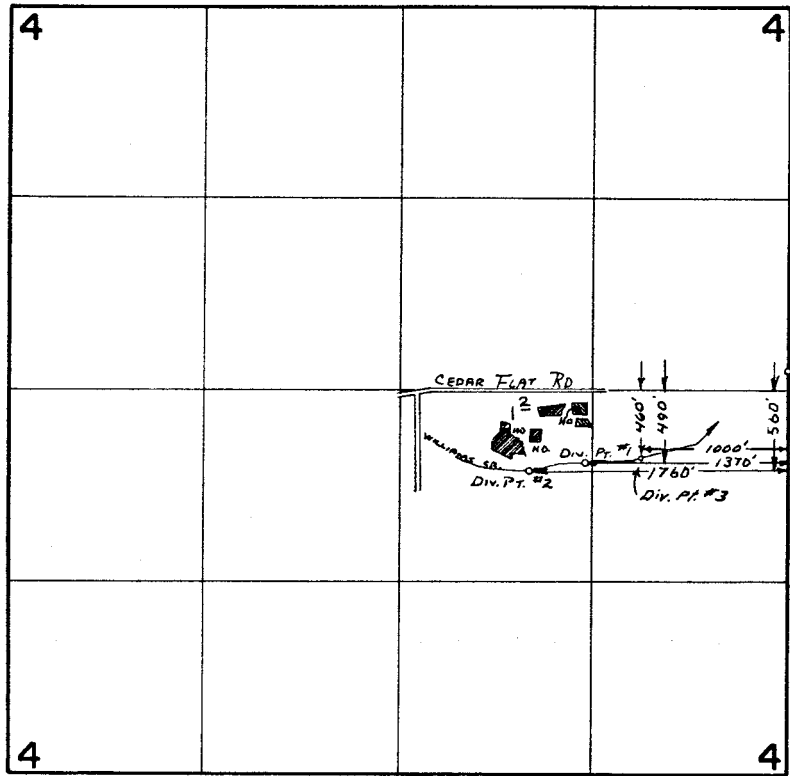

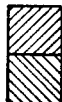 DIV. PT. #2 (0³A)
 DIV. PT. #1 (0³A)

RECEIVED
 JUN 5 1978
 WM. DIST. 14
 BRANTS PASS, CRE

FINAL PROOF SURVEY UNDER

Transfer No. S-189
 Application No. _____ Permit No. 15111
 IN NAME OF
 _____ VAN R. SOUTHWOOD _____
 Surveyed SEPT. 12 1974, by L. T. ...