

TOWNSHIP 35 S, RANGE 7 W.

Stream: PICKETT CR


TRIB: ROGUE R

Priority: 4/06/44

North

West

East

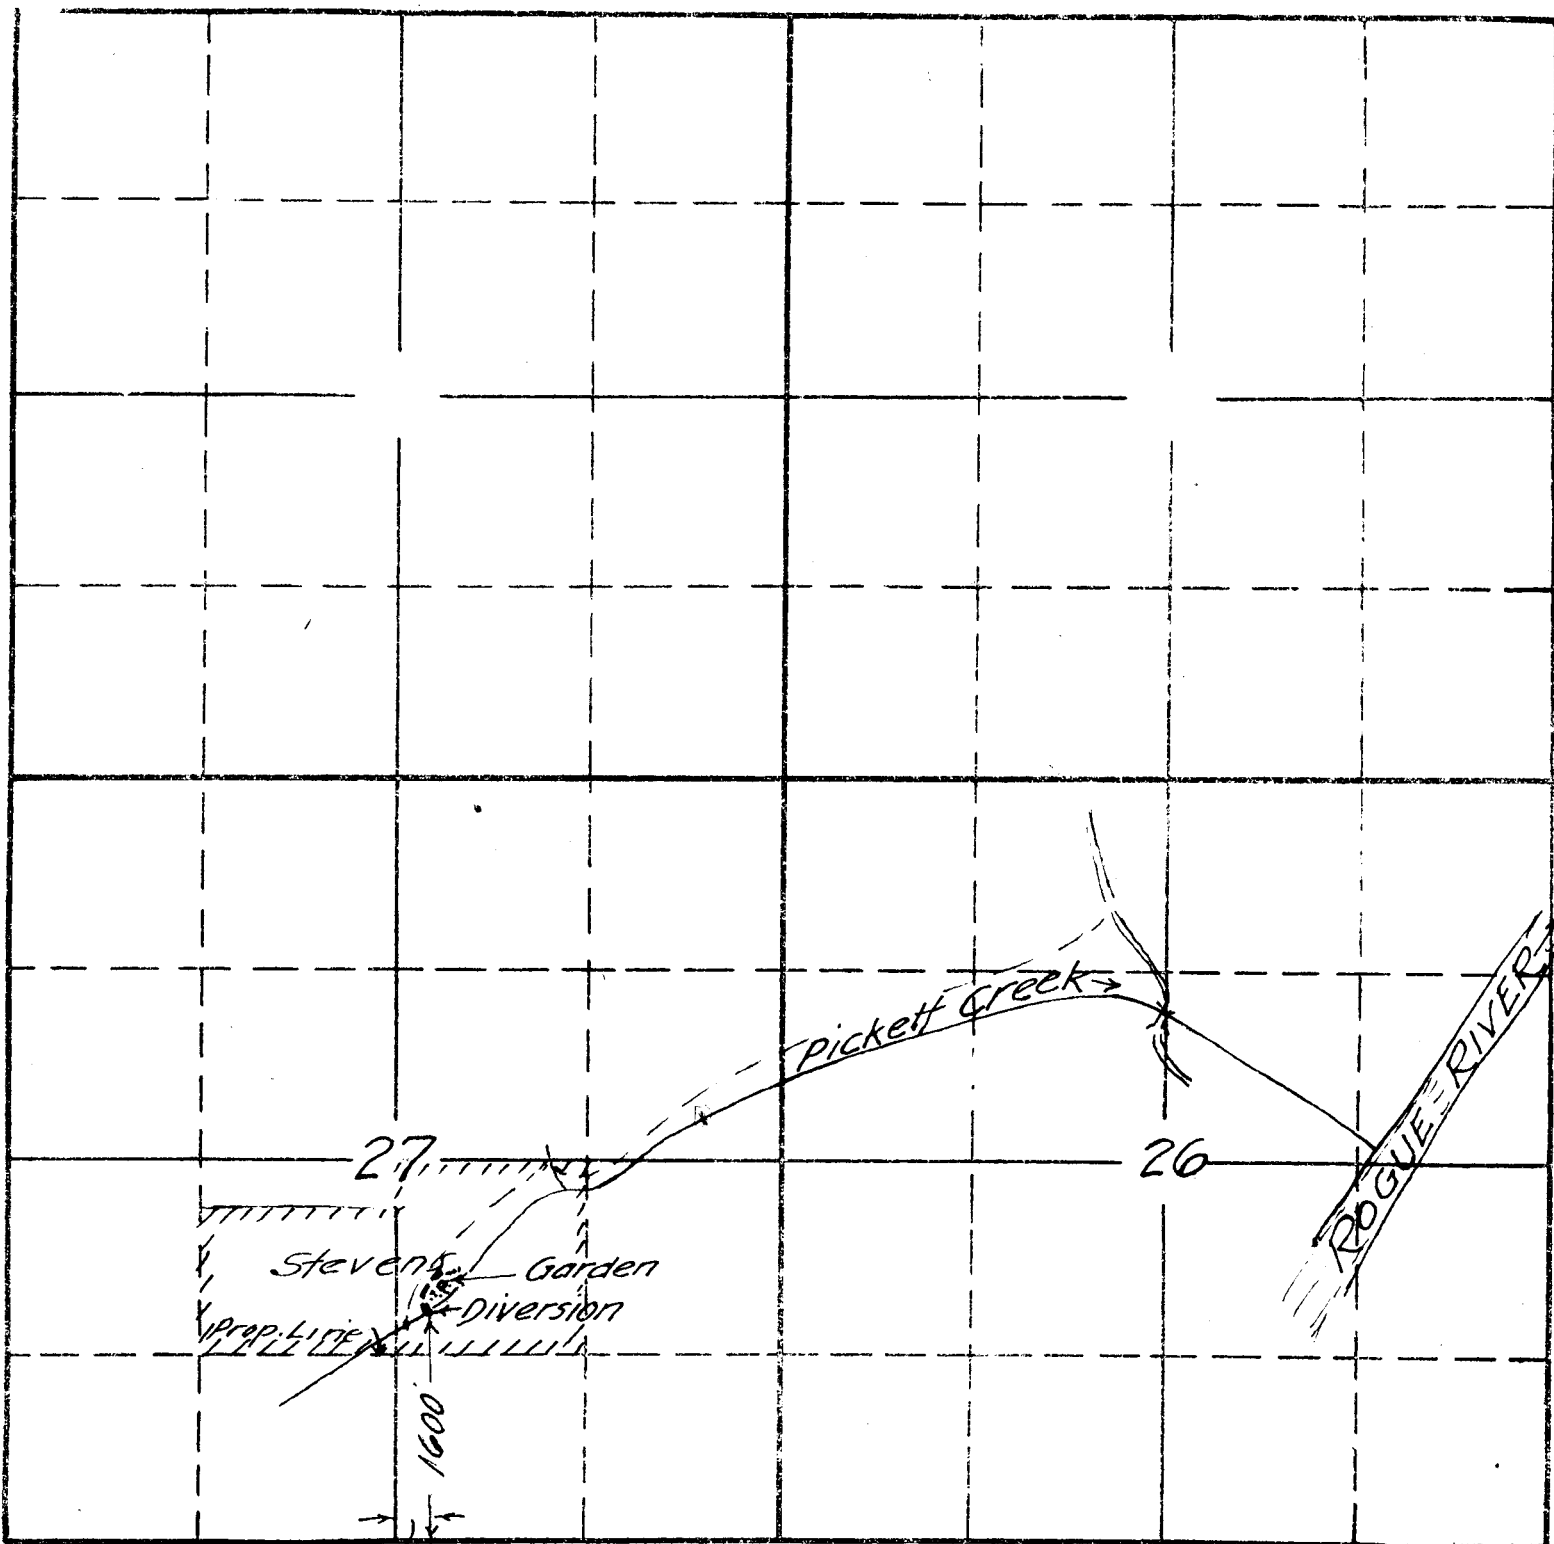

South

.01 of S
4-6-44

John F. Stevens & Hazel D. Stevens
April 1944

APPLICATION No. 20190

PERMIT No. 15742