


TOWNSHIP 37 S, RANGE 7 W, W. M.

North

West

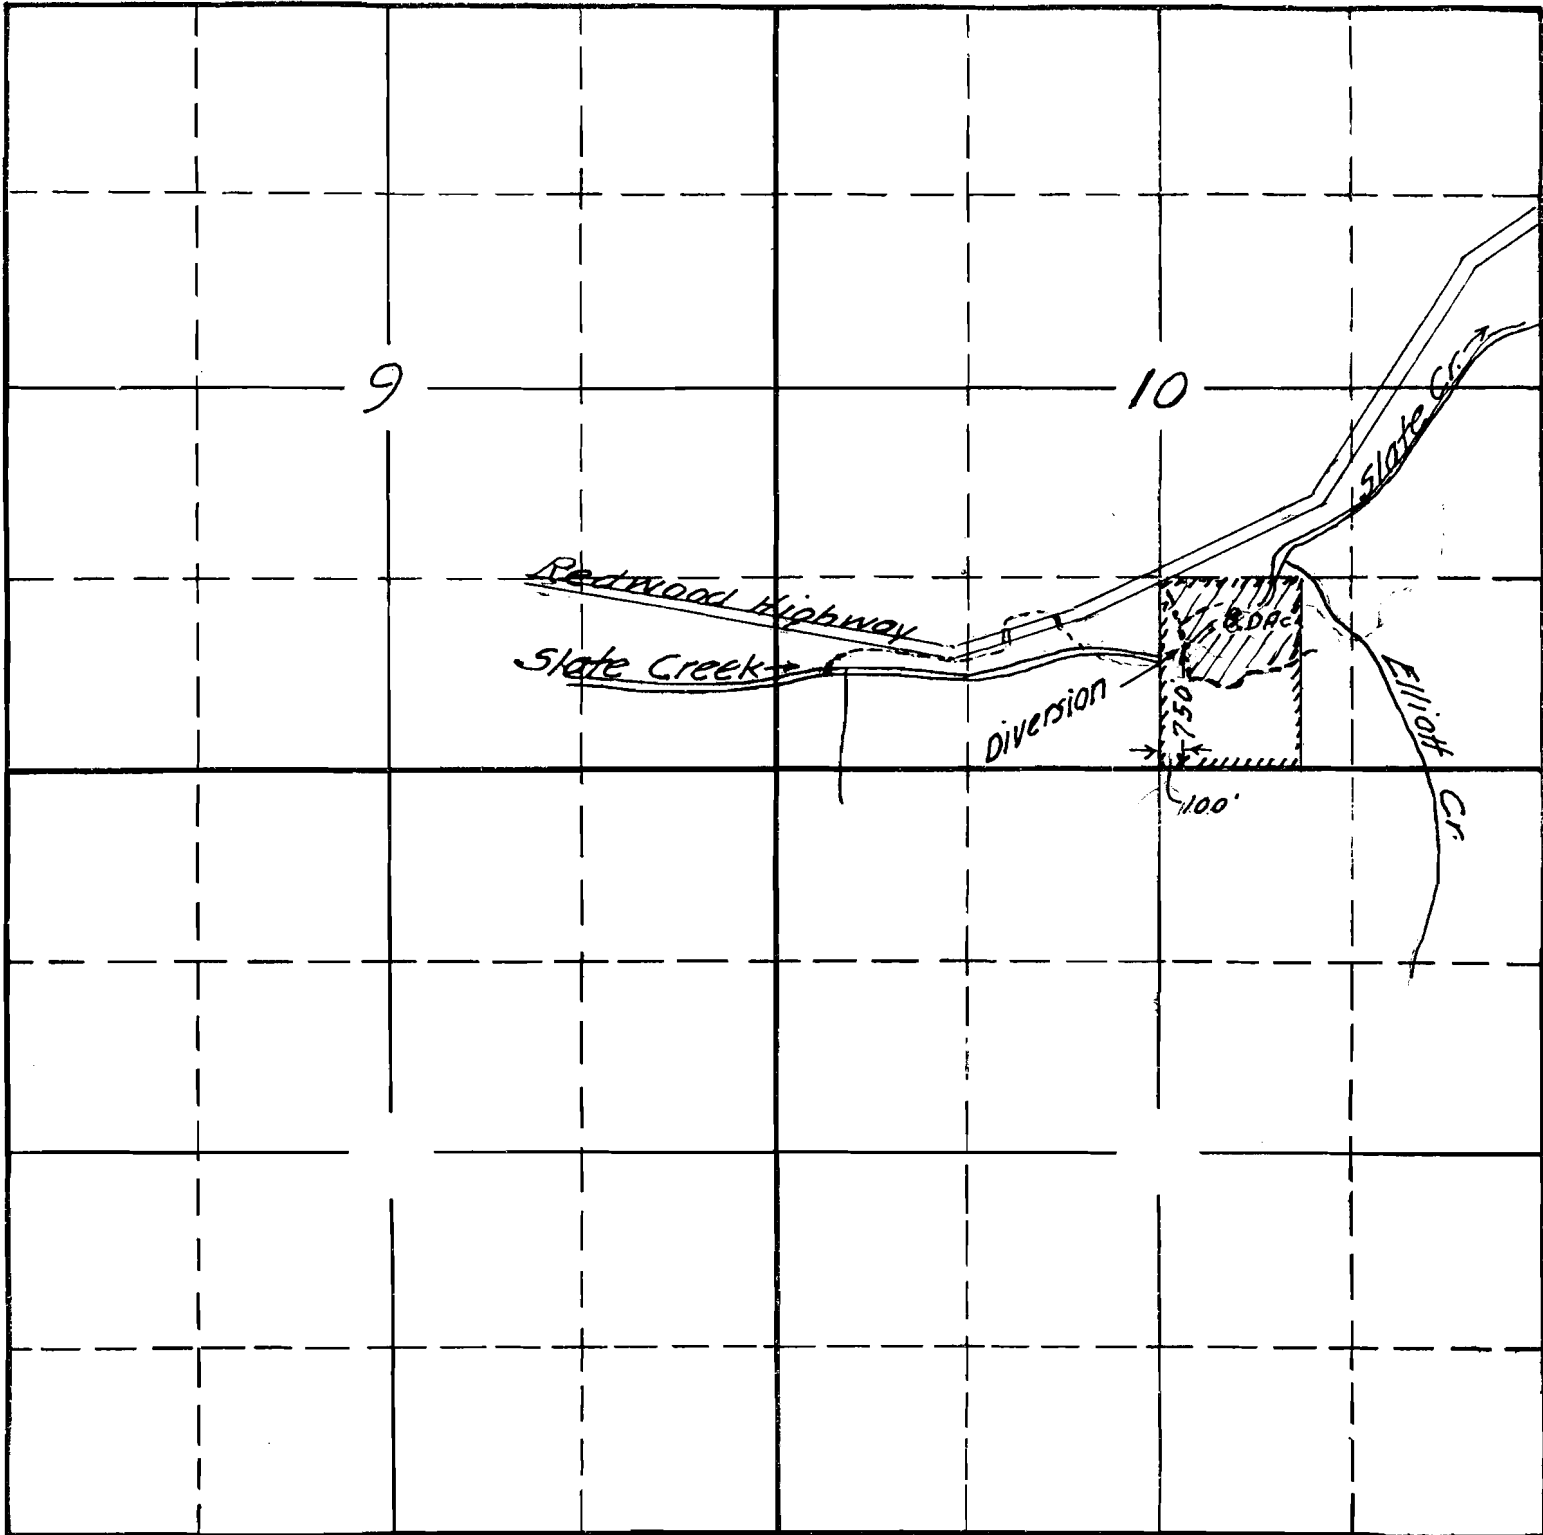

South

20199 OK
15-10-44

RECEIVED

Joseph L. Clement
April 1944

APPLICATION No. 20199

PERMIT No.

