


26

TOWNSHIP 39 S., RANGE 8 W., W. M.

North

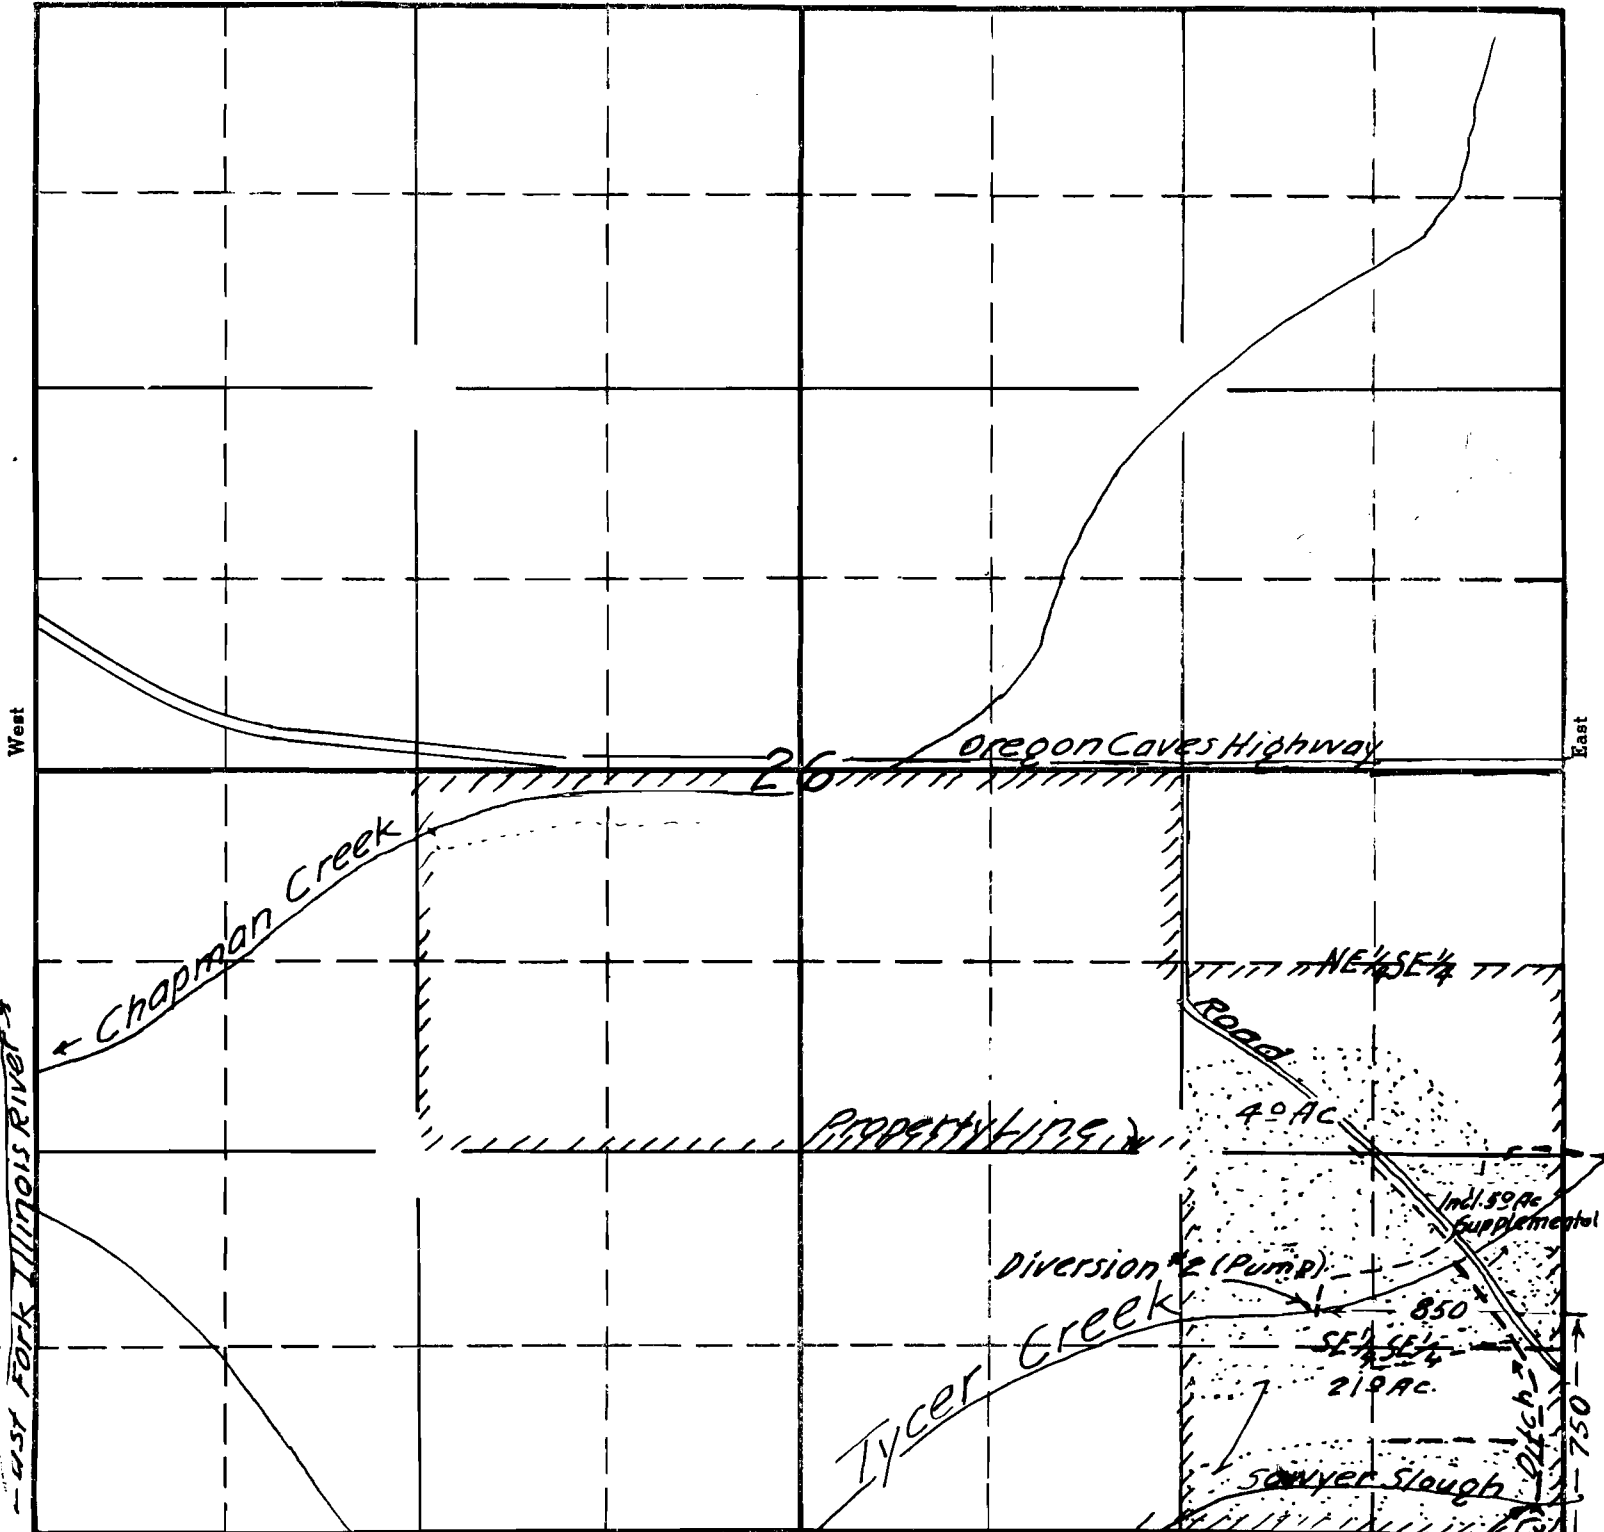

South

RECEIVED
 STATE ENGINEER
 OREGON

Edith L. Sowell
 May 1944
 Scale 8" = 1 Mile

APPLICATION No. 20236
 PERMIT No. 15777