


6

TOWNSHIP 36 S, RANGE 1 W, W. M.

North

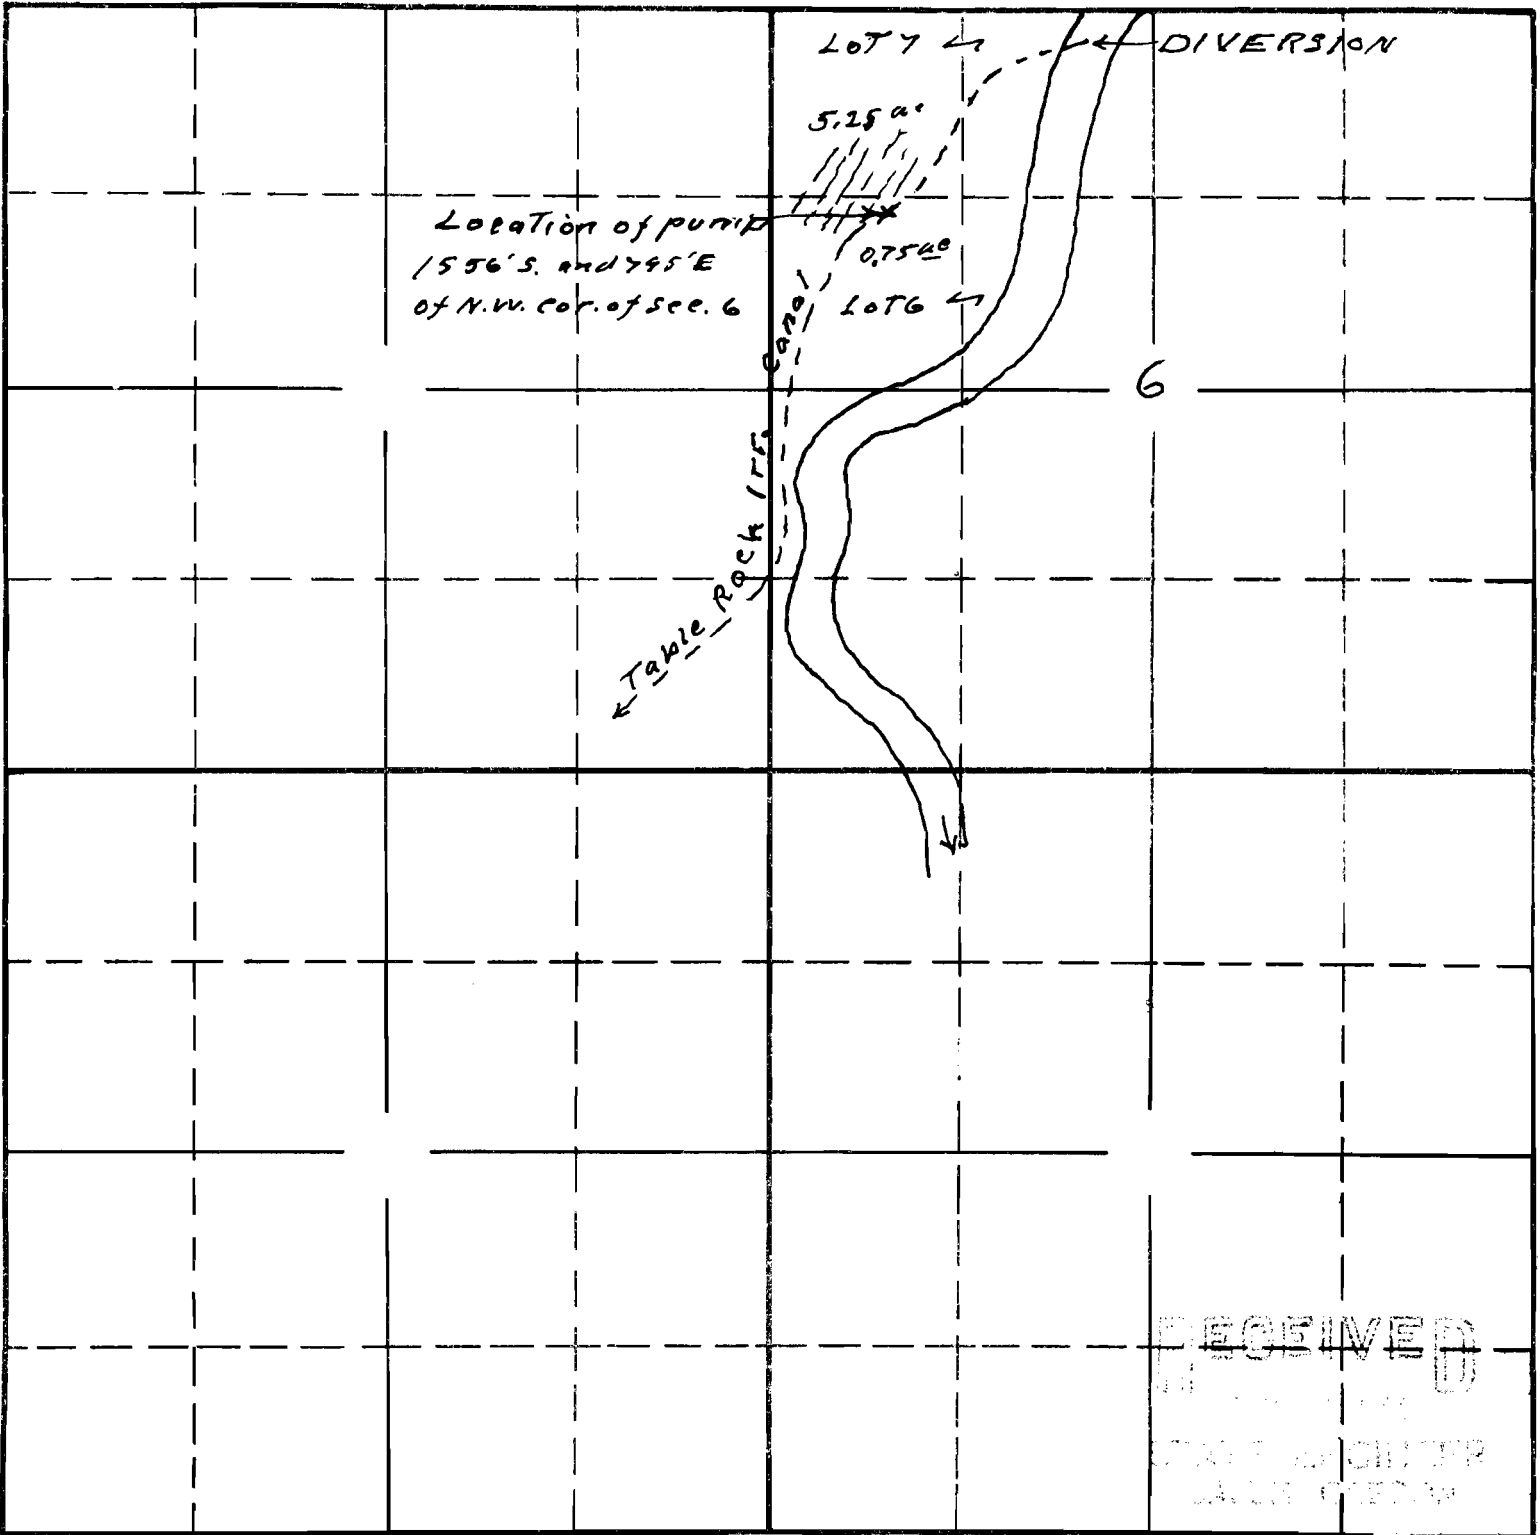

RECEIVED  
 MAY 22 1944  
 STATE ENGINEER  

South

To accompany application of Ray W Ryan  
 for use of waters of Rogue River for  
 irrigation purpose.

APPLICATION No.  
 PERMIT No. 15788

This office 5/22/44 *[Signature]*