


SECTION

\_\_\_\_\_  
\_\_\_\_\_  
\_\_\_\_\_

355  
TOWNSHIP 365, RANGE 4 N., W. M.

North

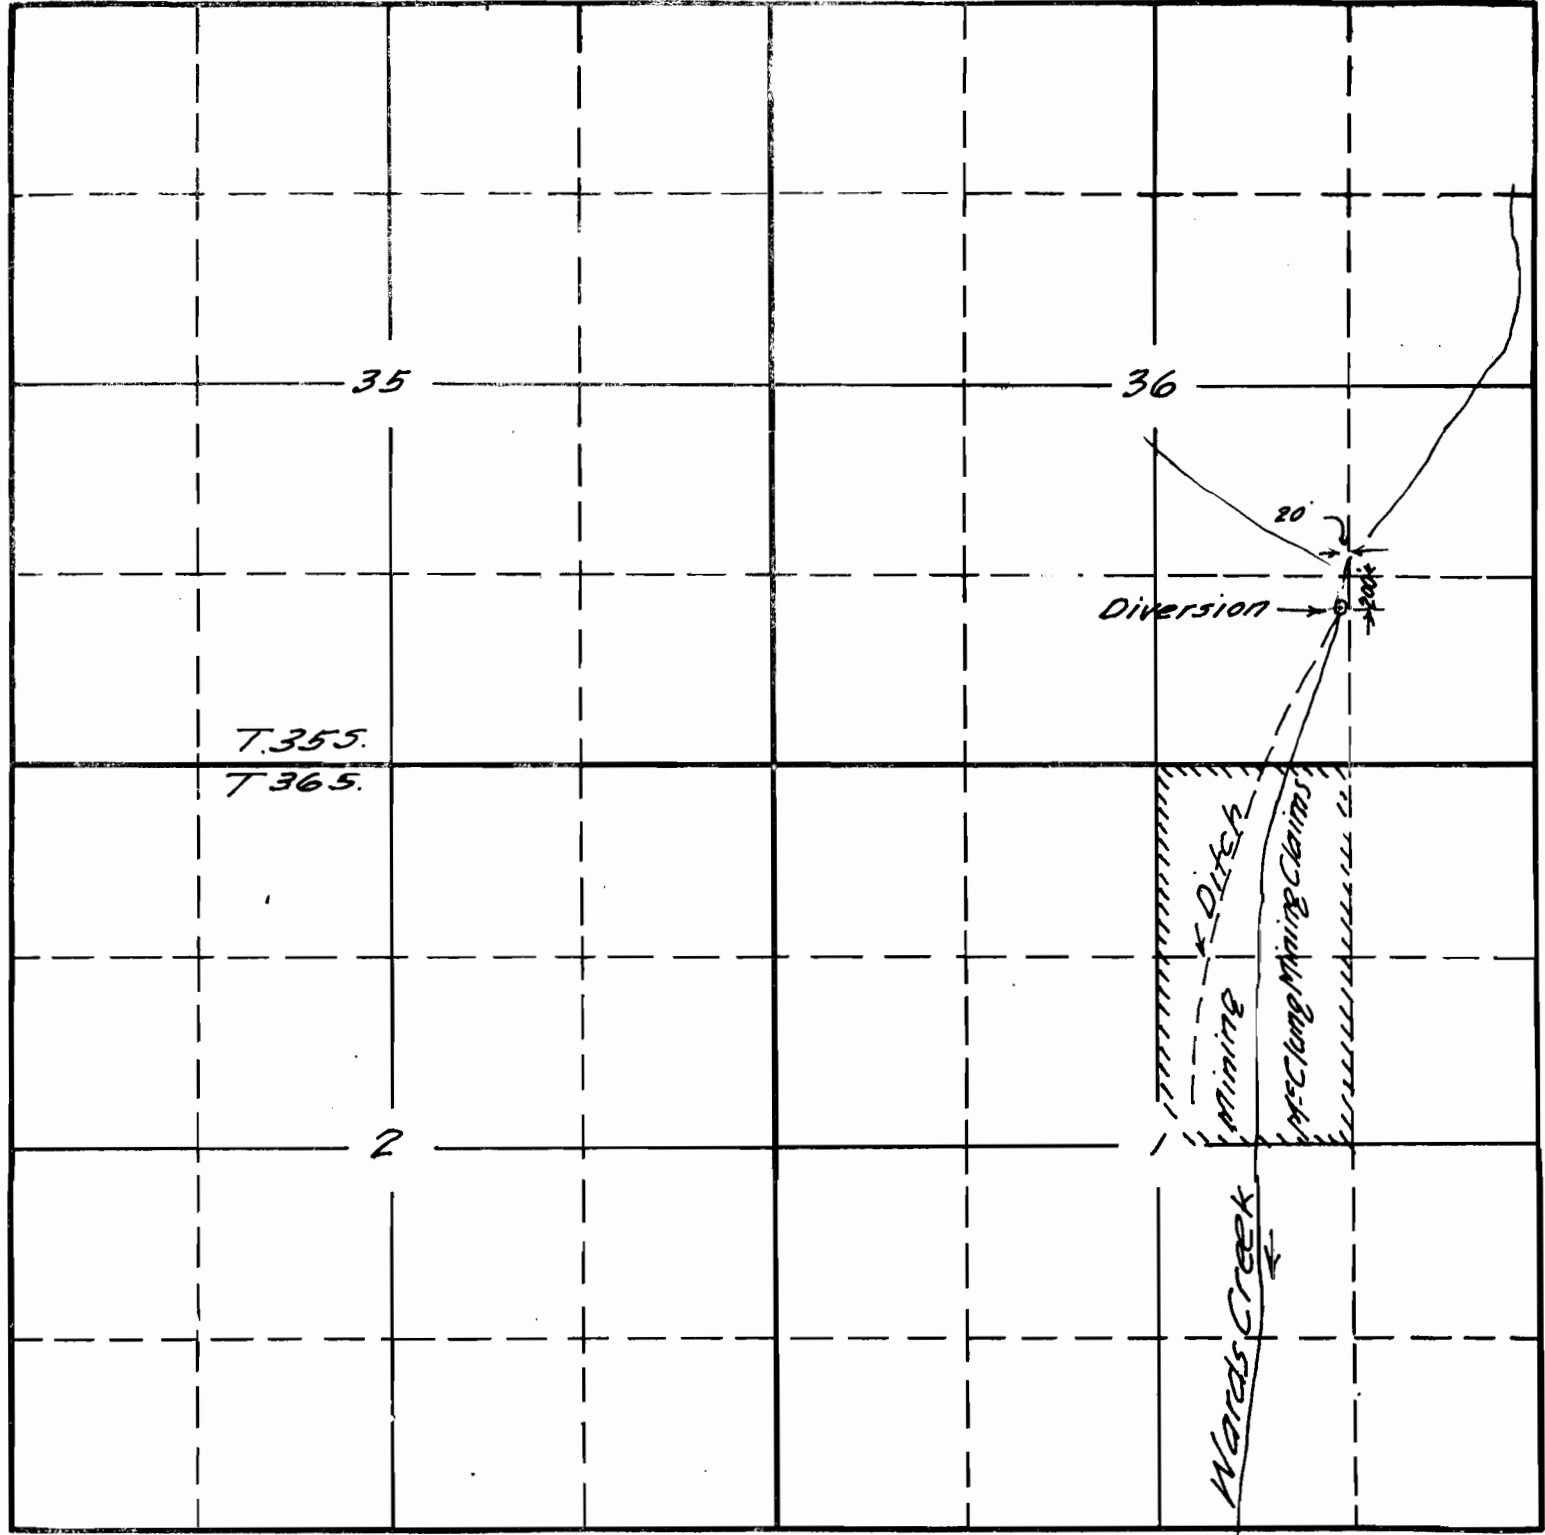

South

*H. H. McClung*

APPLICATION No. 20316  
PERMIT No.