


SECTION

14

TOWNSHIP 39S, RANGE 1E, W. M.

North

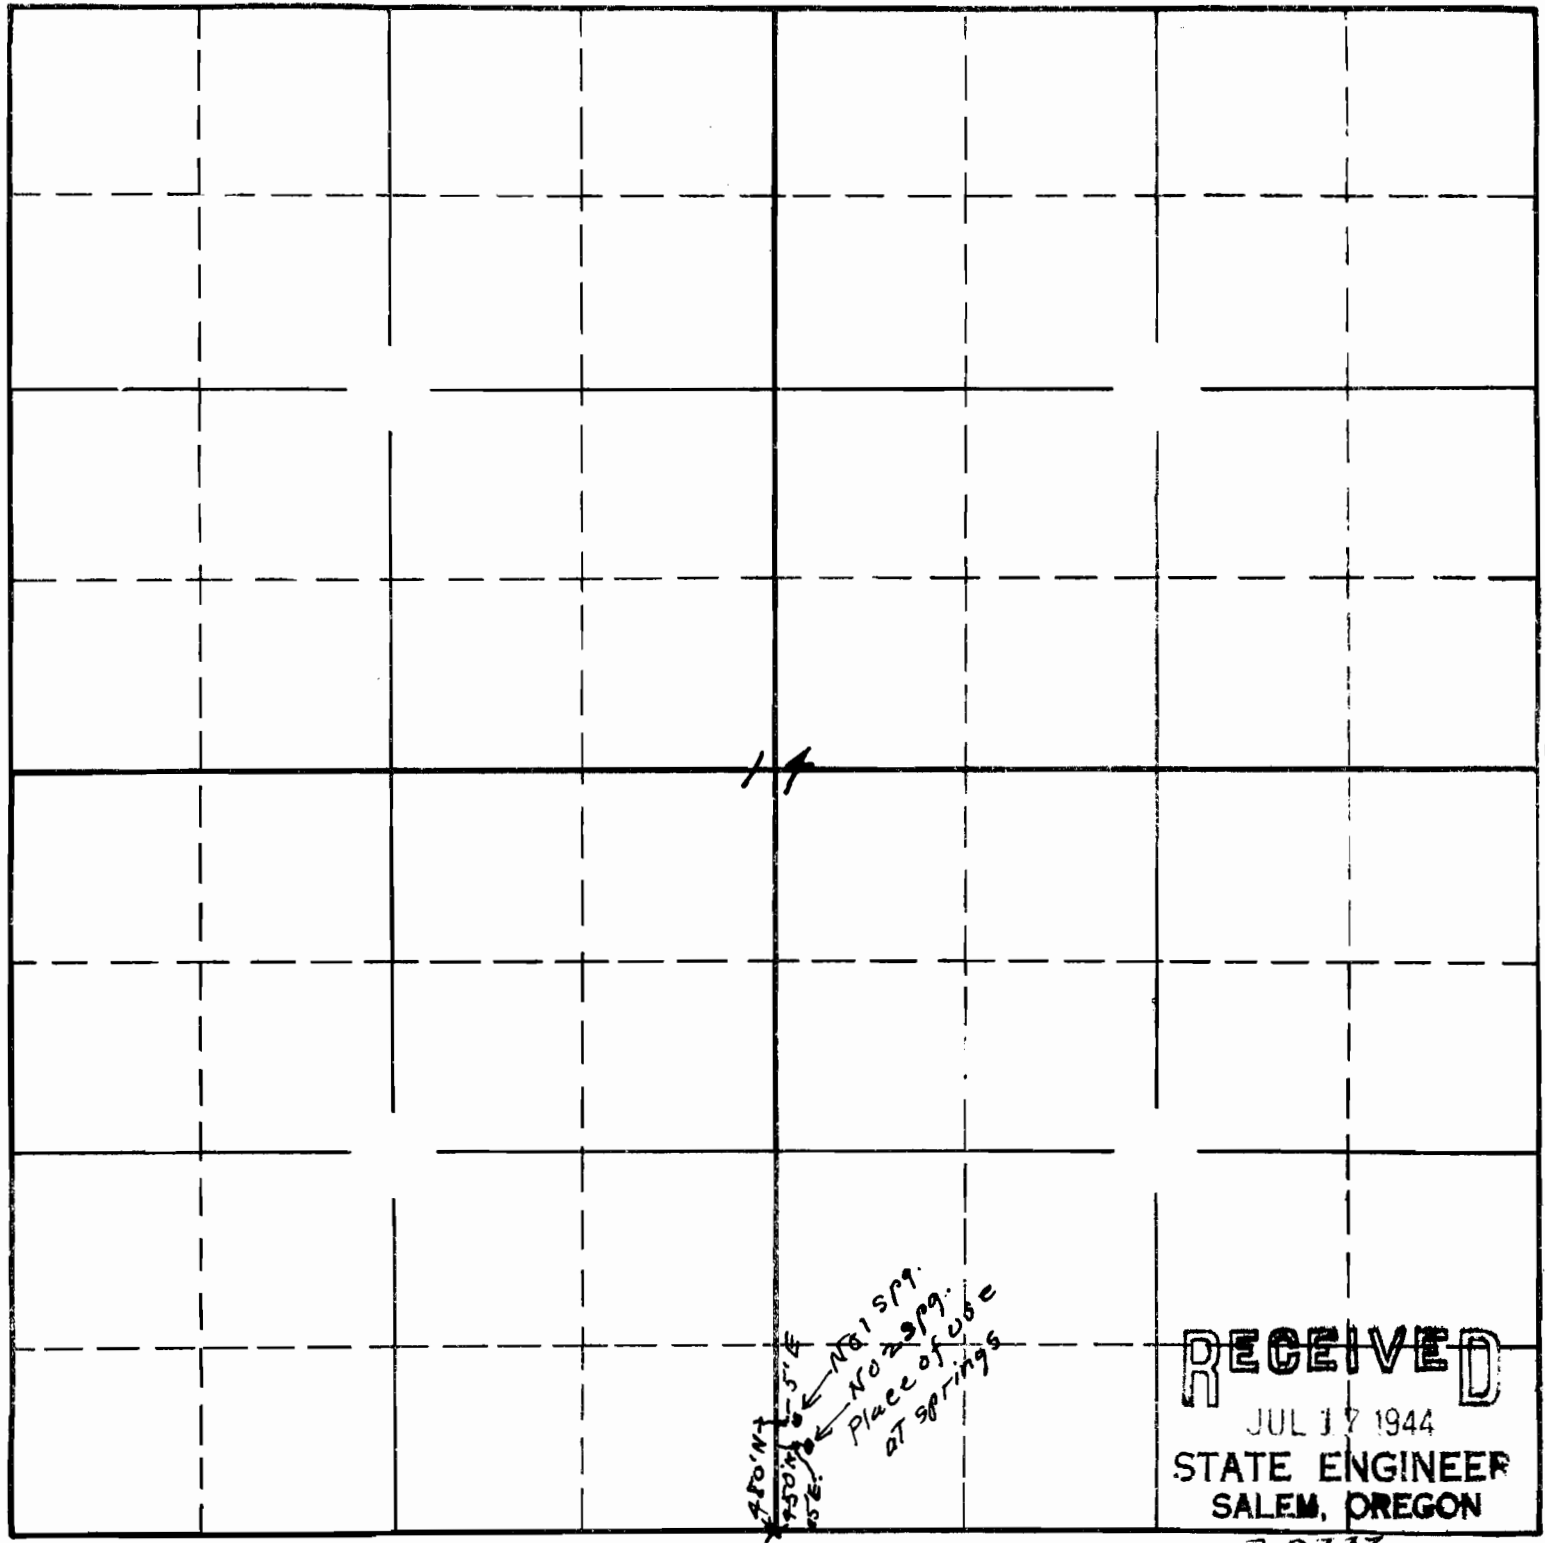

**RECEIVED**  
 JUL 17 1944  
 STATE ENGINEER  
 SALEM, OREGON  
 20333

Sketch to accompany application of  
 George G Sikes for use of No. 1. & No. 2.  
 Springs for domestic & stock purposes.  
 Springs on property of applicant.

APPLICATION No. 20333  
 PERMIT No. 15862

This office 9/20/44