


1-2

TOWNSHIP 39S, RANGE 3W, W. M.

North

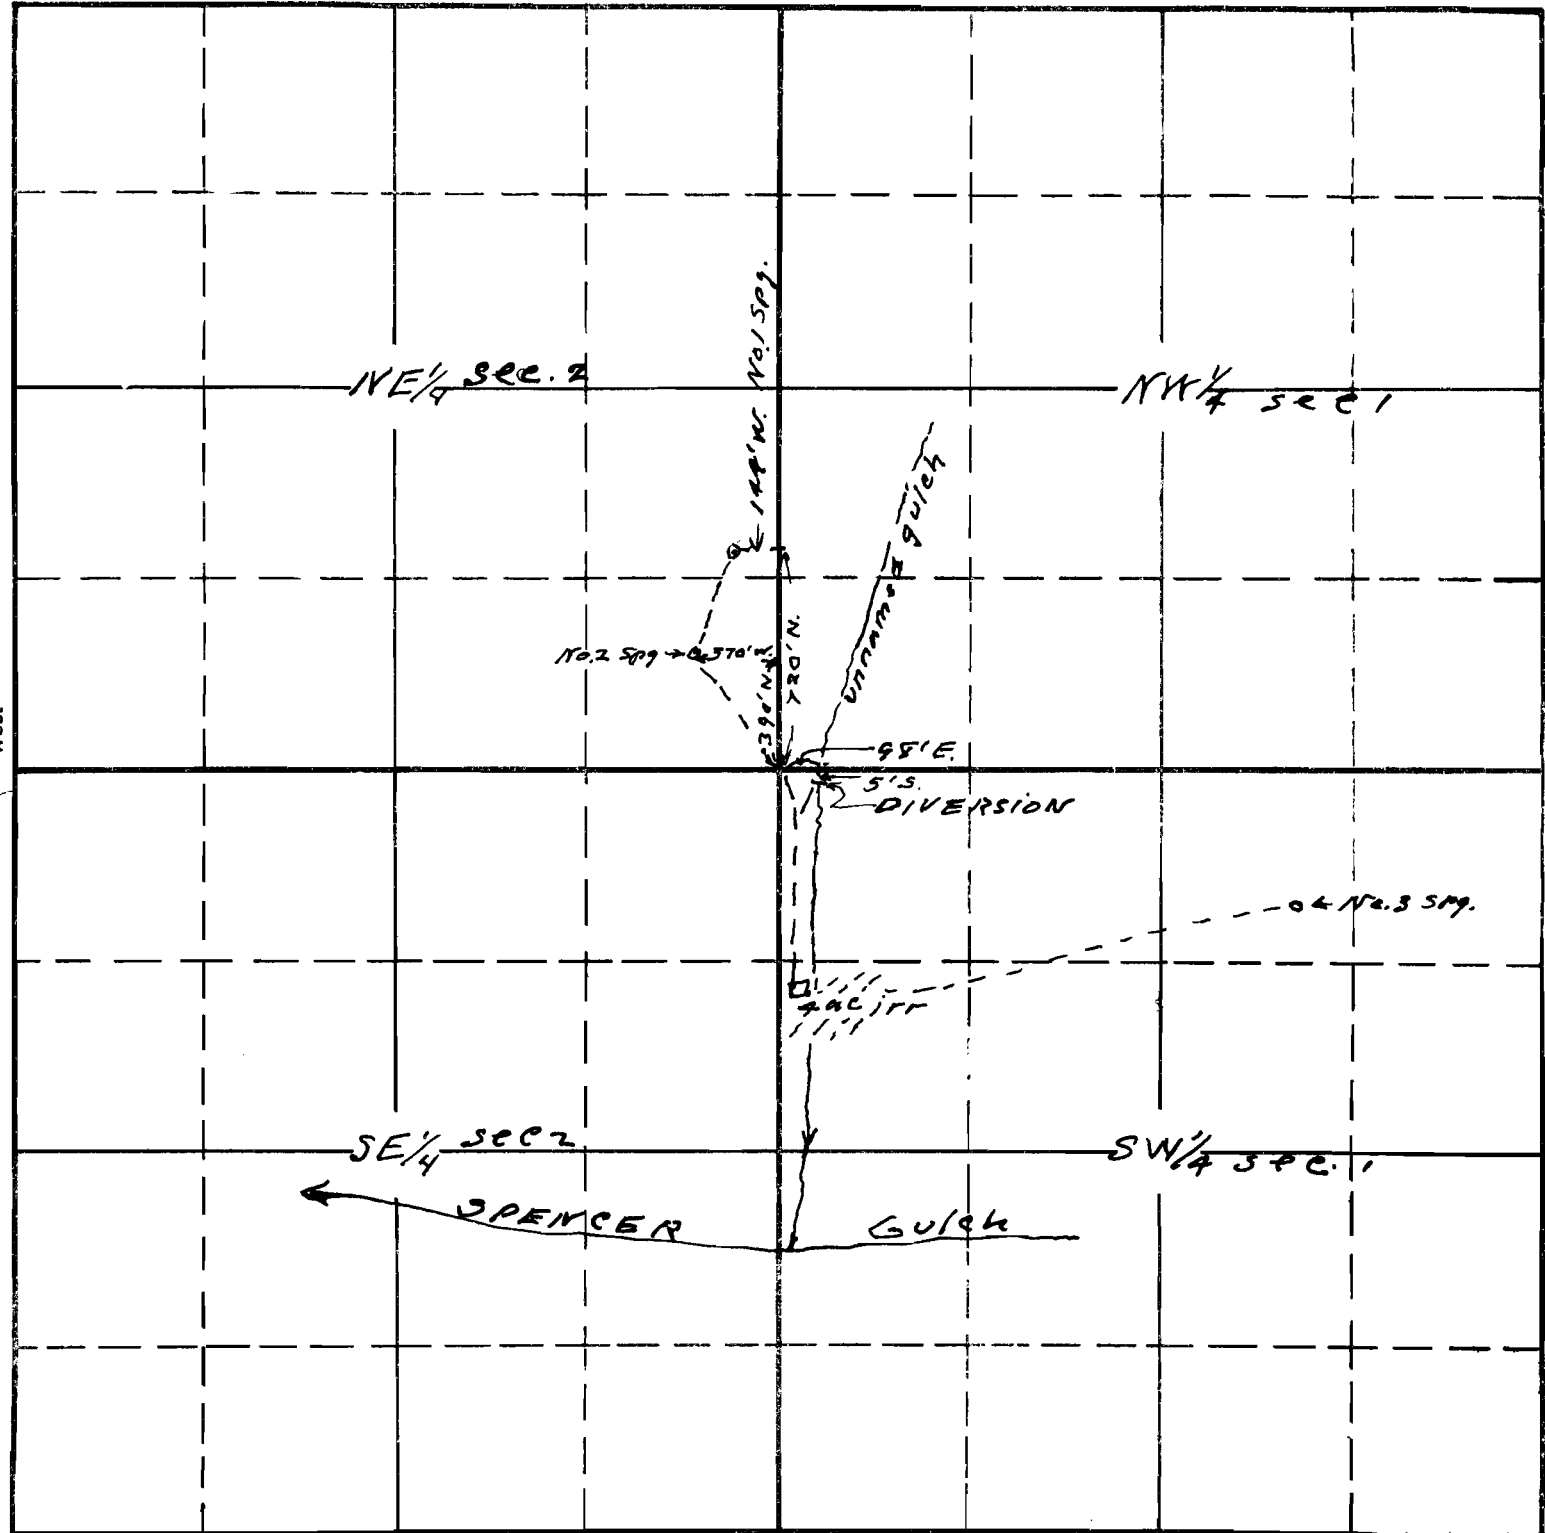

South

Map to accompany application of
 Chester R Purcell for use of waters
 of three springs and unnamed gulch
 trip Spencer Gulch. Springs do not
 run into any stream system

APPLICATION No. 20384
 PERMIT No. 15897

This office 8/5/44