


SECTION

Permit: S 15951  
Volume: 6  
Strm: APPELEGATE R  
Trib: ROGUE R  
Priority: 8/28/44

TOWNSHIP 36 S, RANGE 6 W.

North

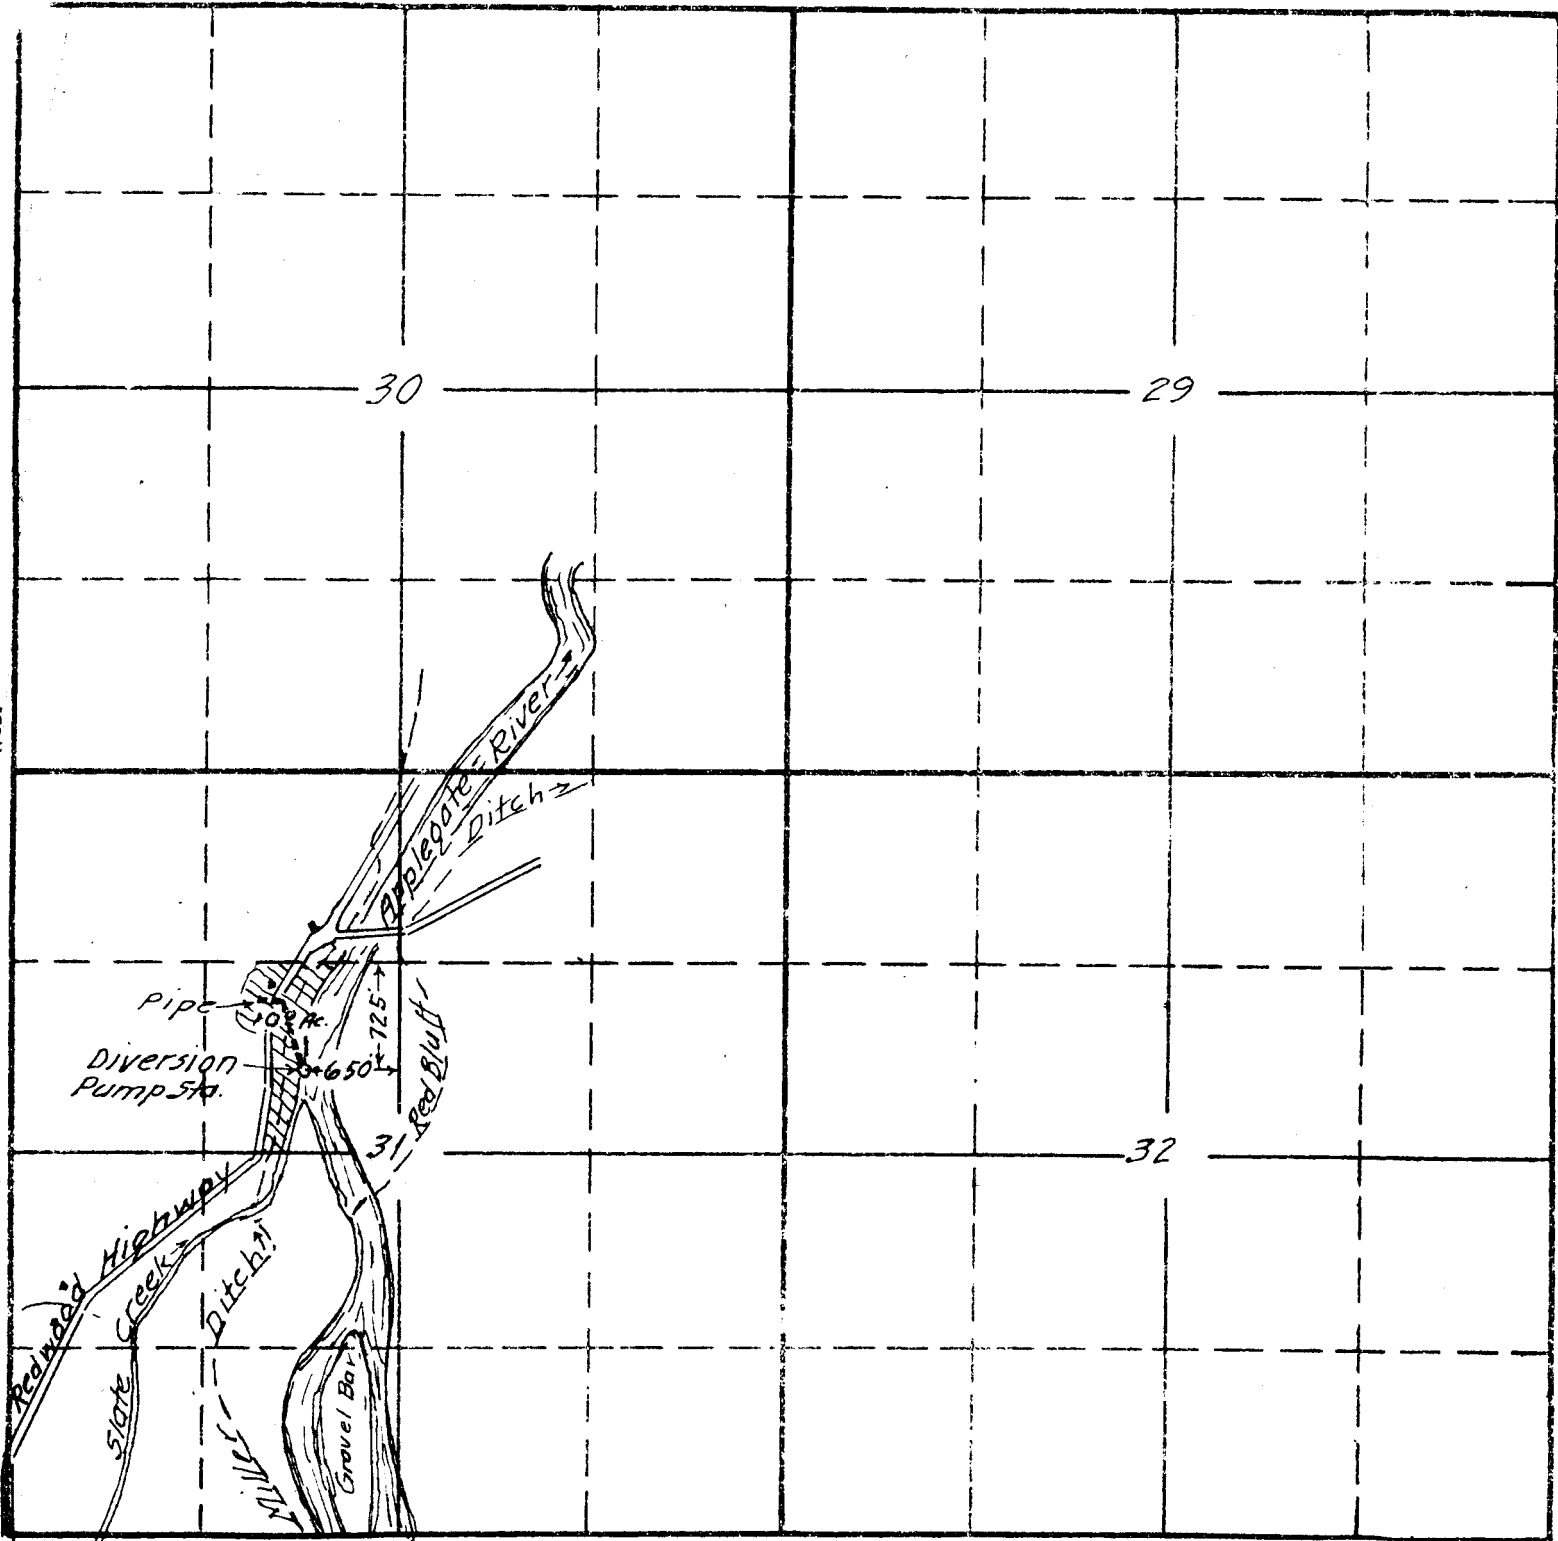

South

W.W. Savage and W.E. Savage  
Aug. 1944.

20427  
APPLICATION No. 20427  
PERMIT No. 15951