


RECEIVED

DEPARTMENT OF AGRICULTURE
WASHINGTON, D. C.

N

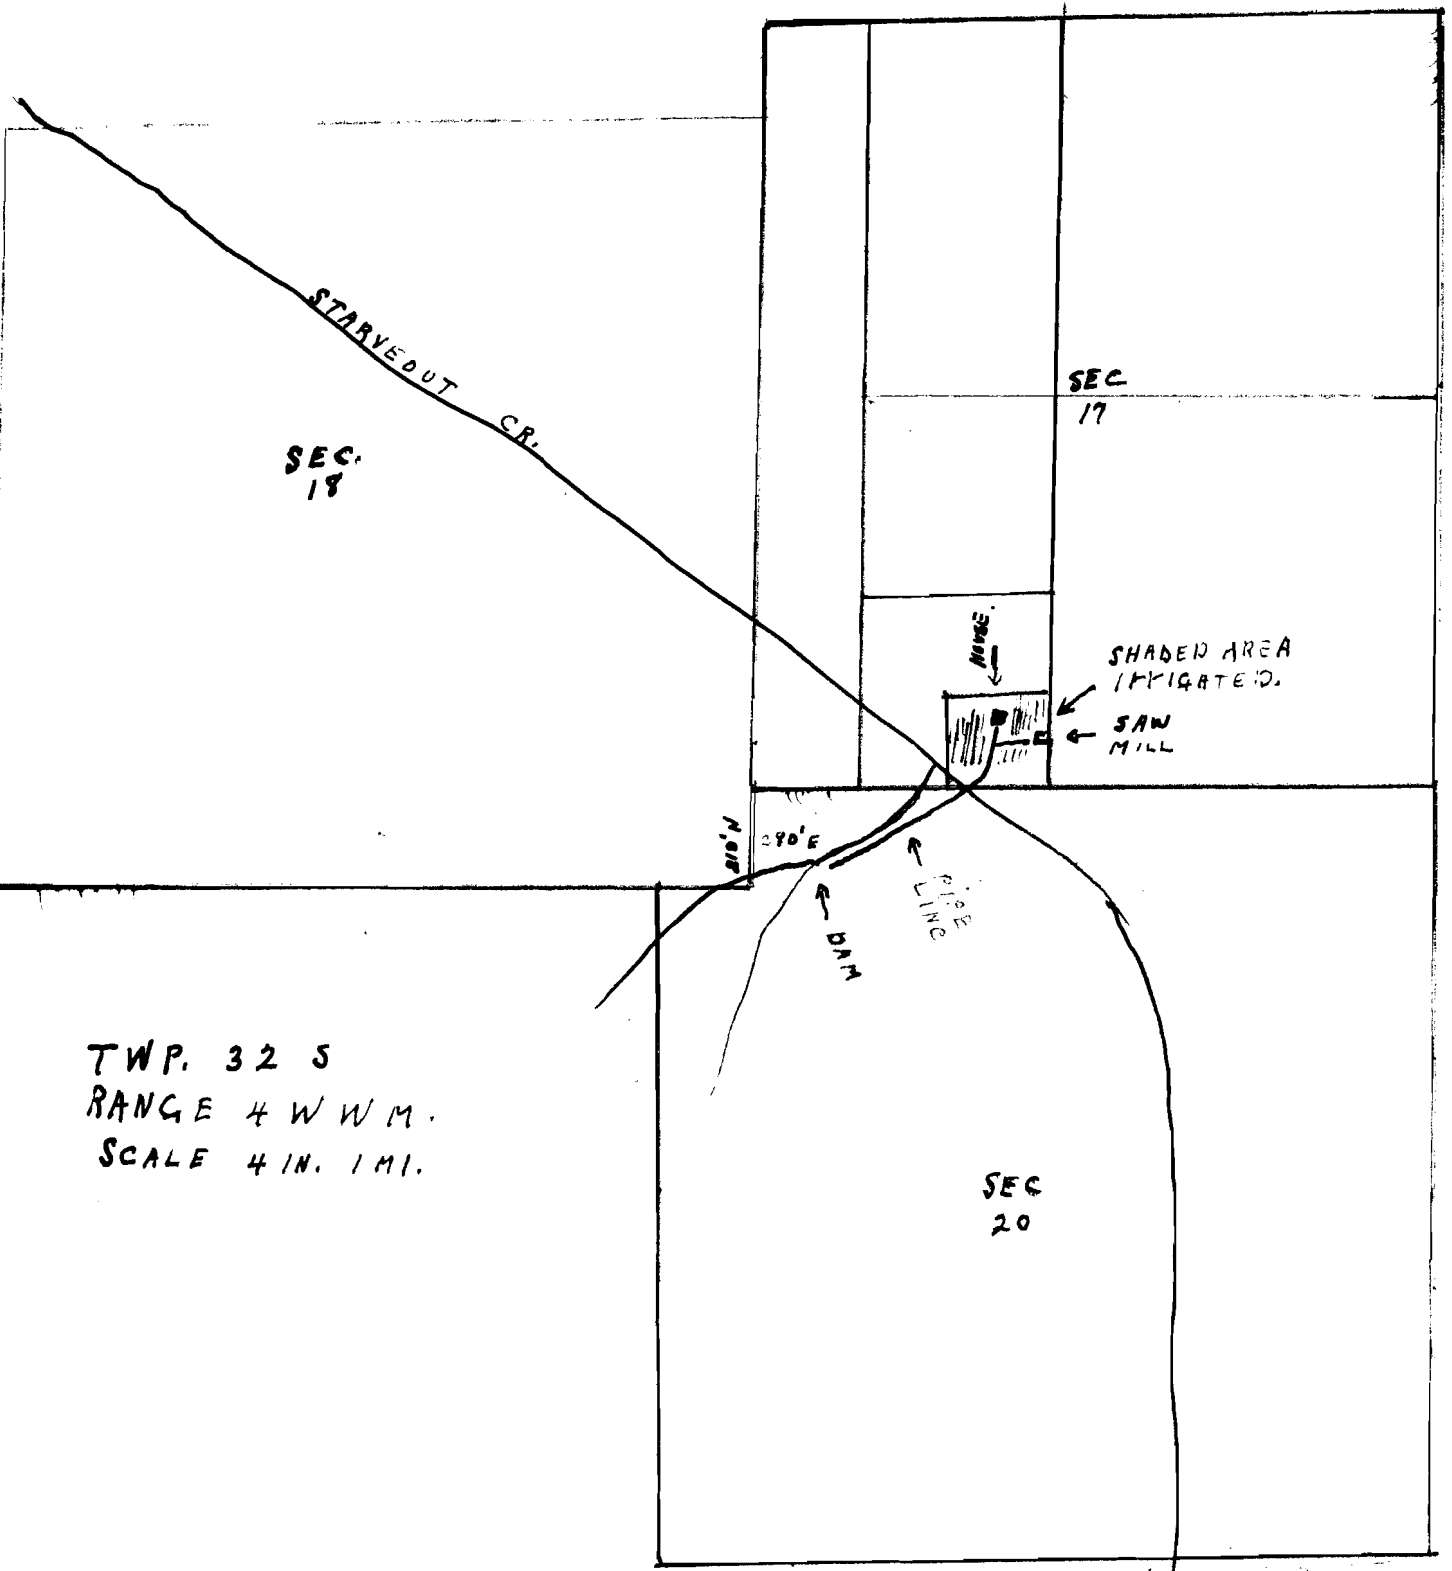

TWP. 32 S
RANGE 4 W W M.
SCALE 4 IN. 1 MI.

S

E

Application No. 20485
Permit No. 15998