


SECTION 28  
- 1/2 D.L.C of Thomas  
Ollivant, et ux  
No. 51

TOWNSHIP 28 S, RANGE 7 W, W. M.

North

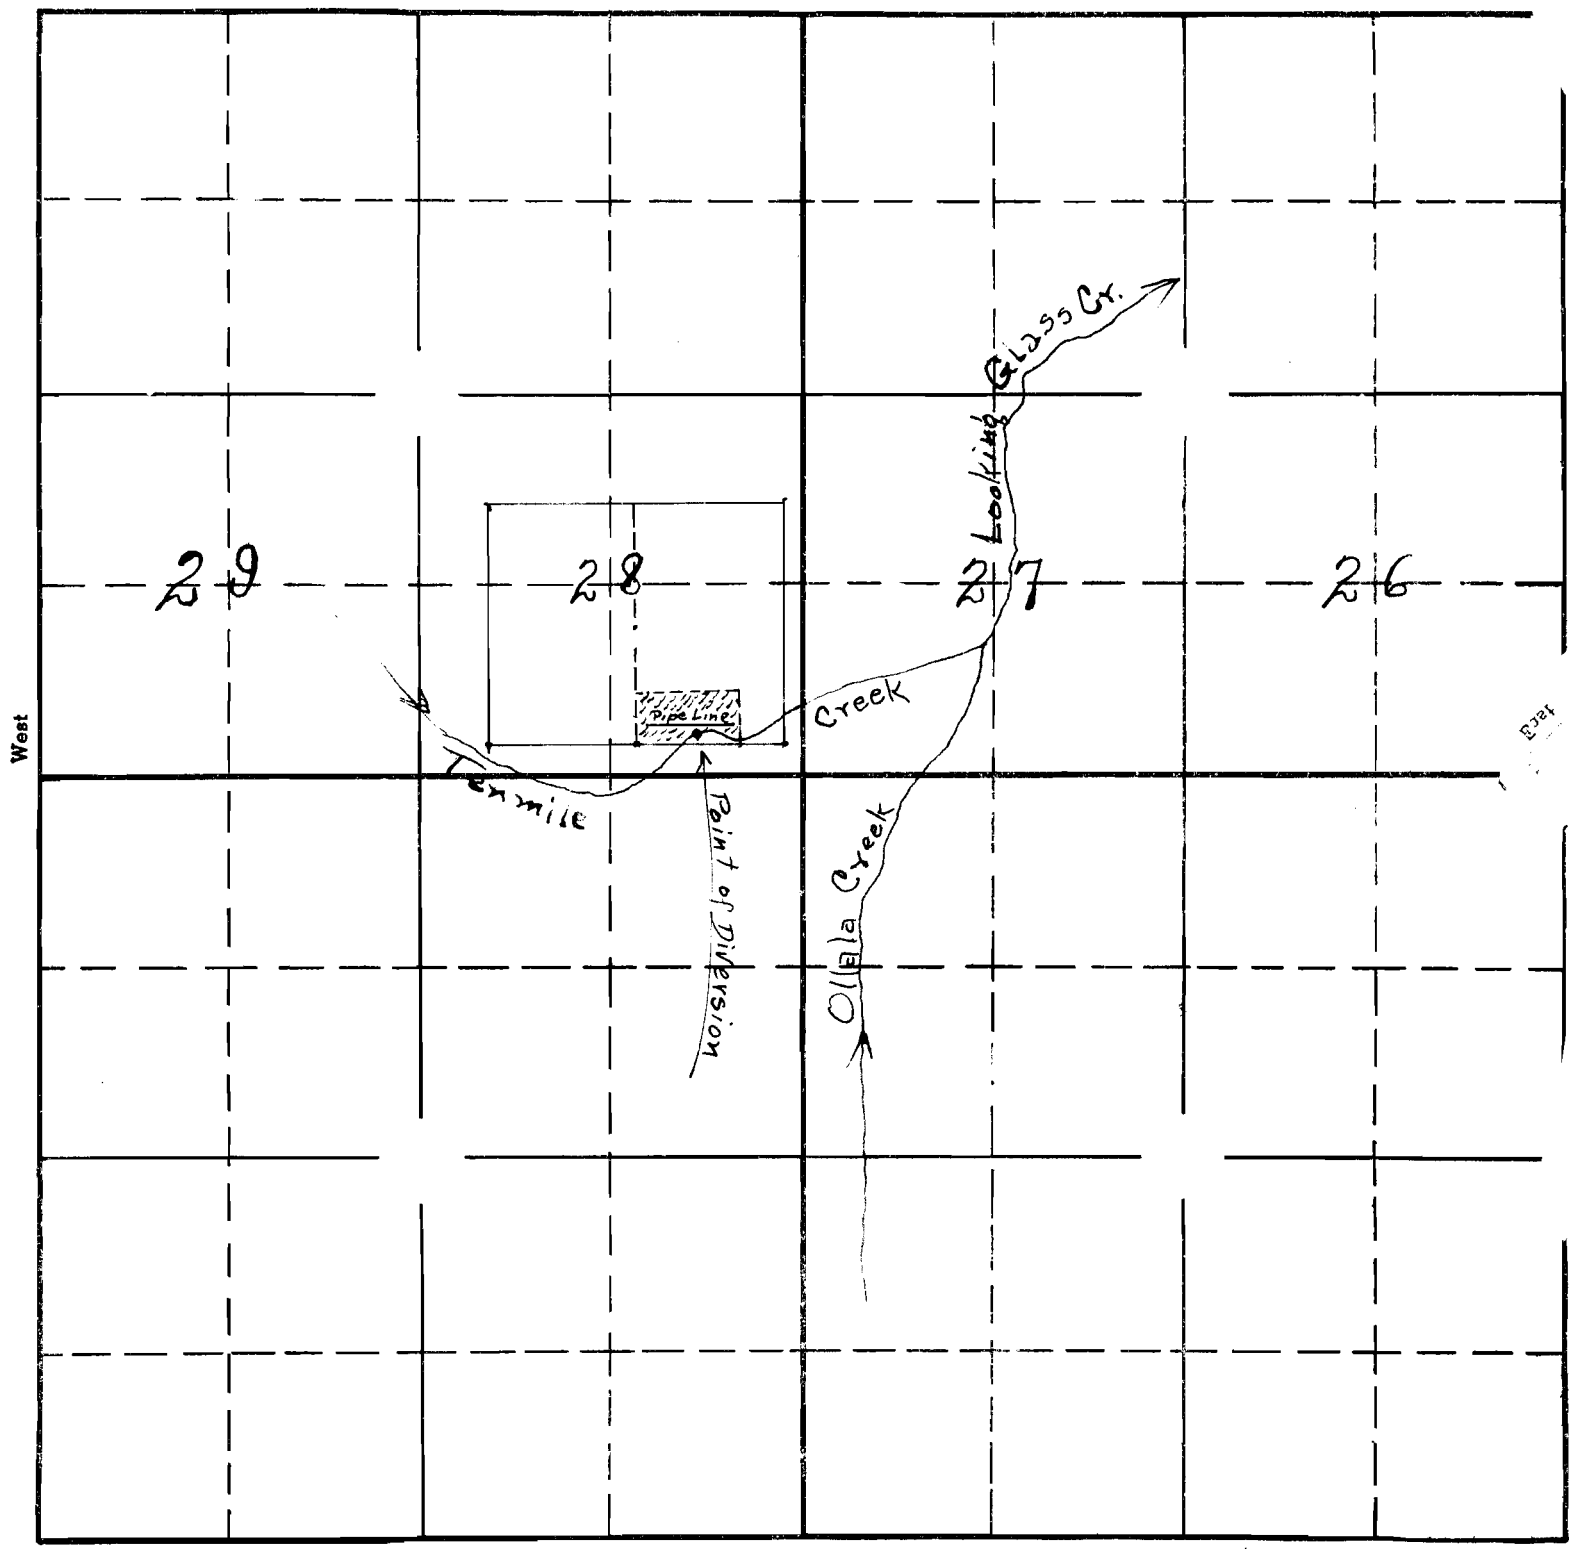

South

**RECEIVED**  
SEP 25 1944  
STATE ENGINEER  
SALEM, OREGON

APPLICATION No. 20495  
PERMIT No. 15000