


SECTION

SECTION 11

TOWNSHIP 8 N , RANGE 7 W , W. M.

North

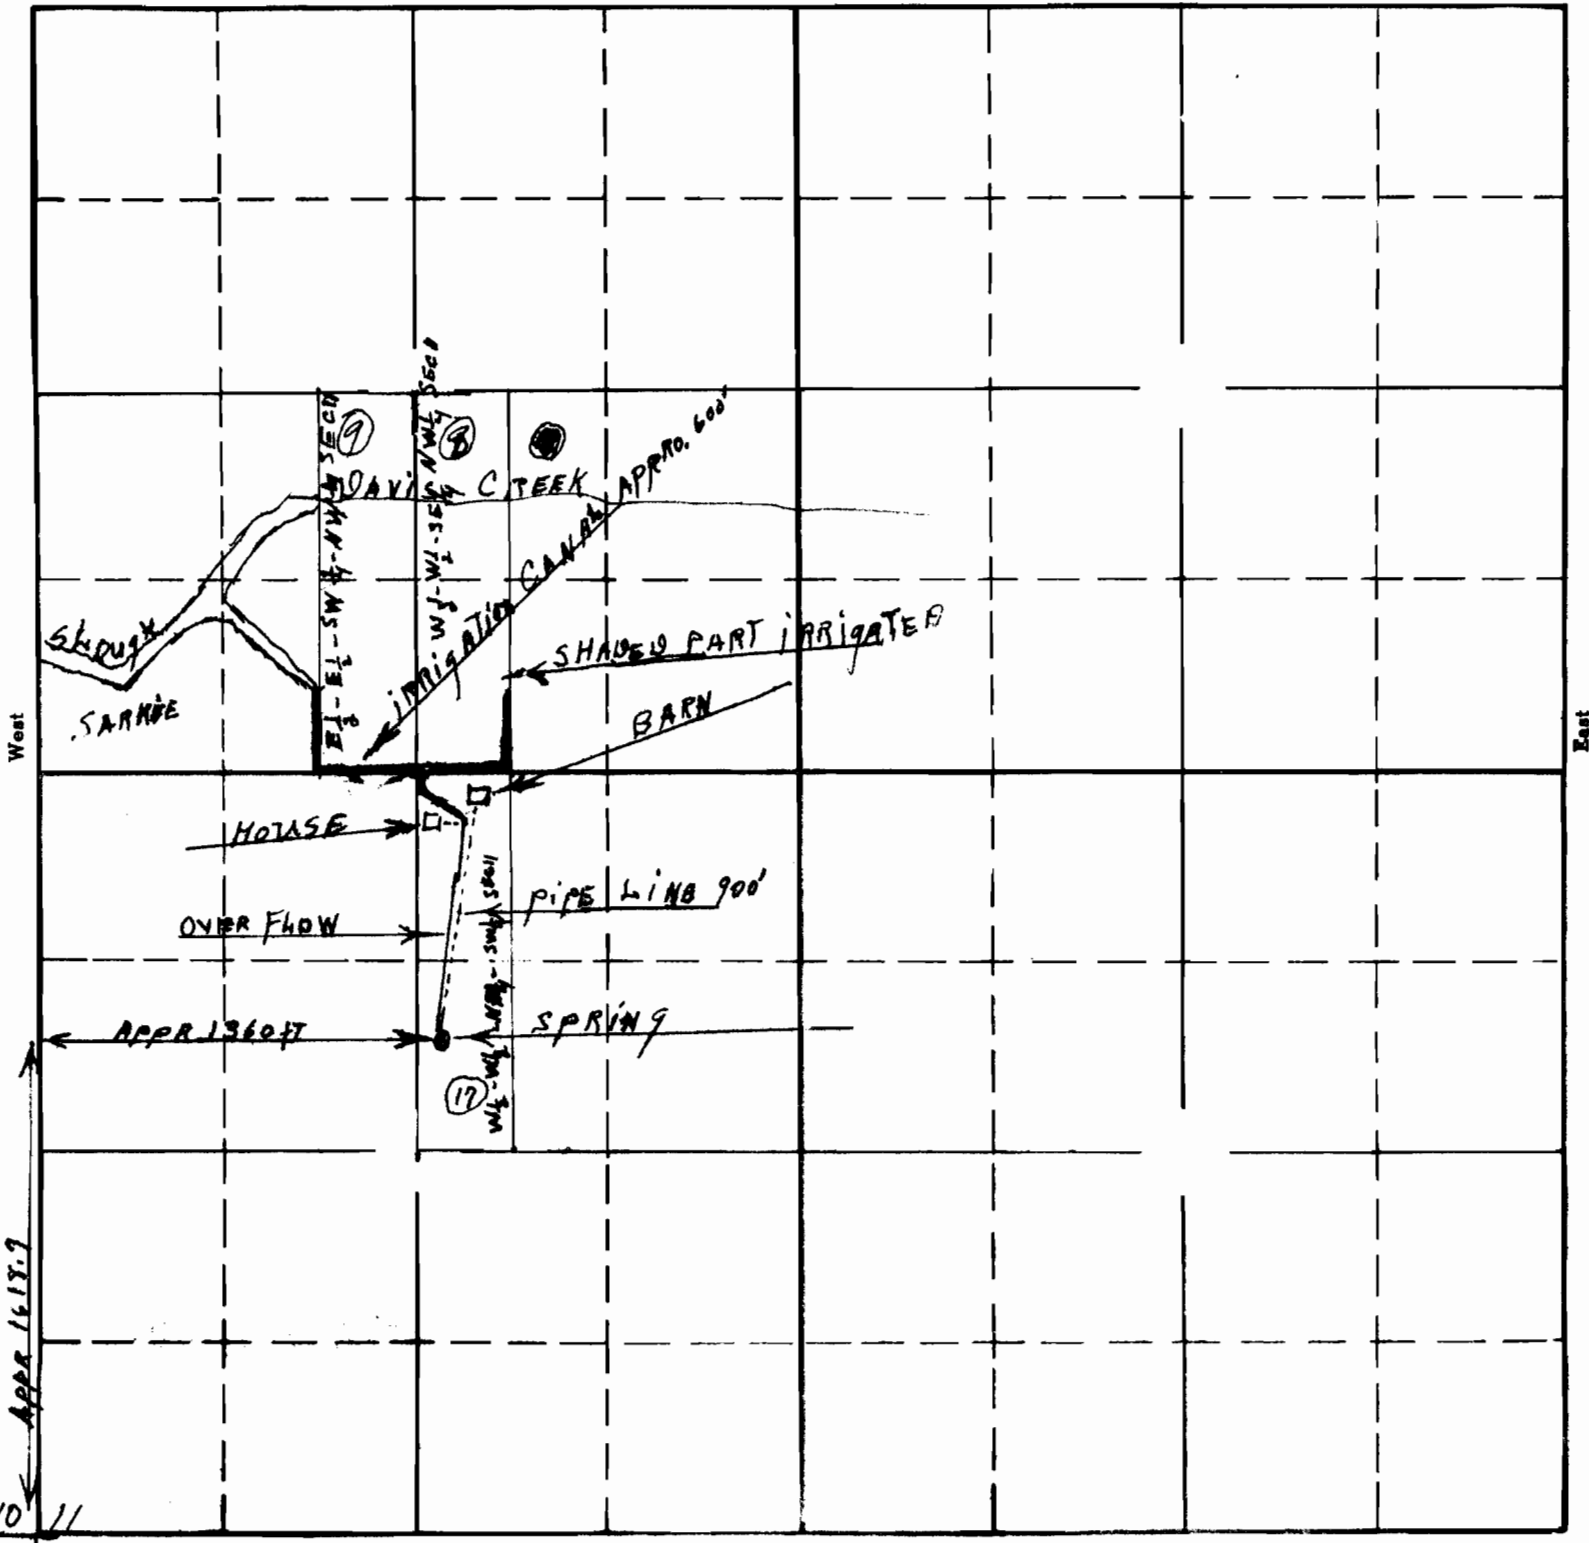

10 11
15 14

South

APPLICATION No. 20565

PERMIT No. 1607

GORNER SECTION 10-11-14-15
APPLICANT OWNS TRACTS 17-8-9 and SARHIE

Joel Siskie
P.O. Box 620
Astoria, Ore