


SECTION

TOWNSHIP 36 S., RANGE 5 W., W. M.

North

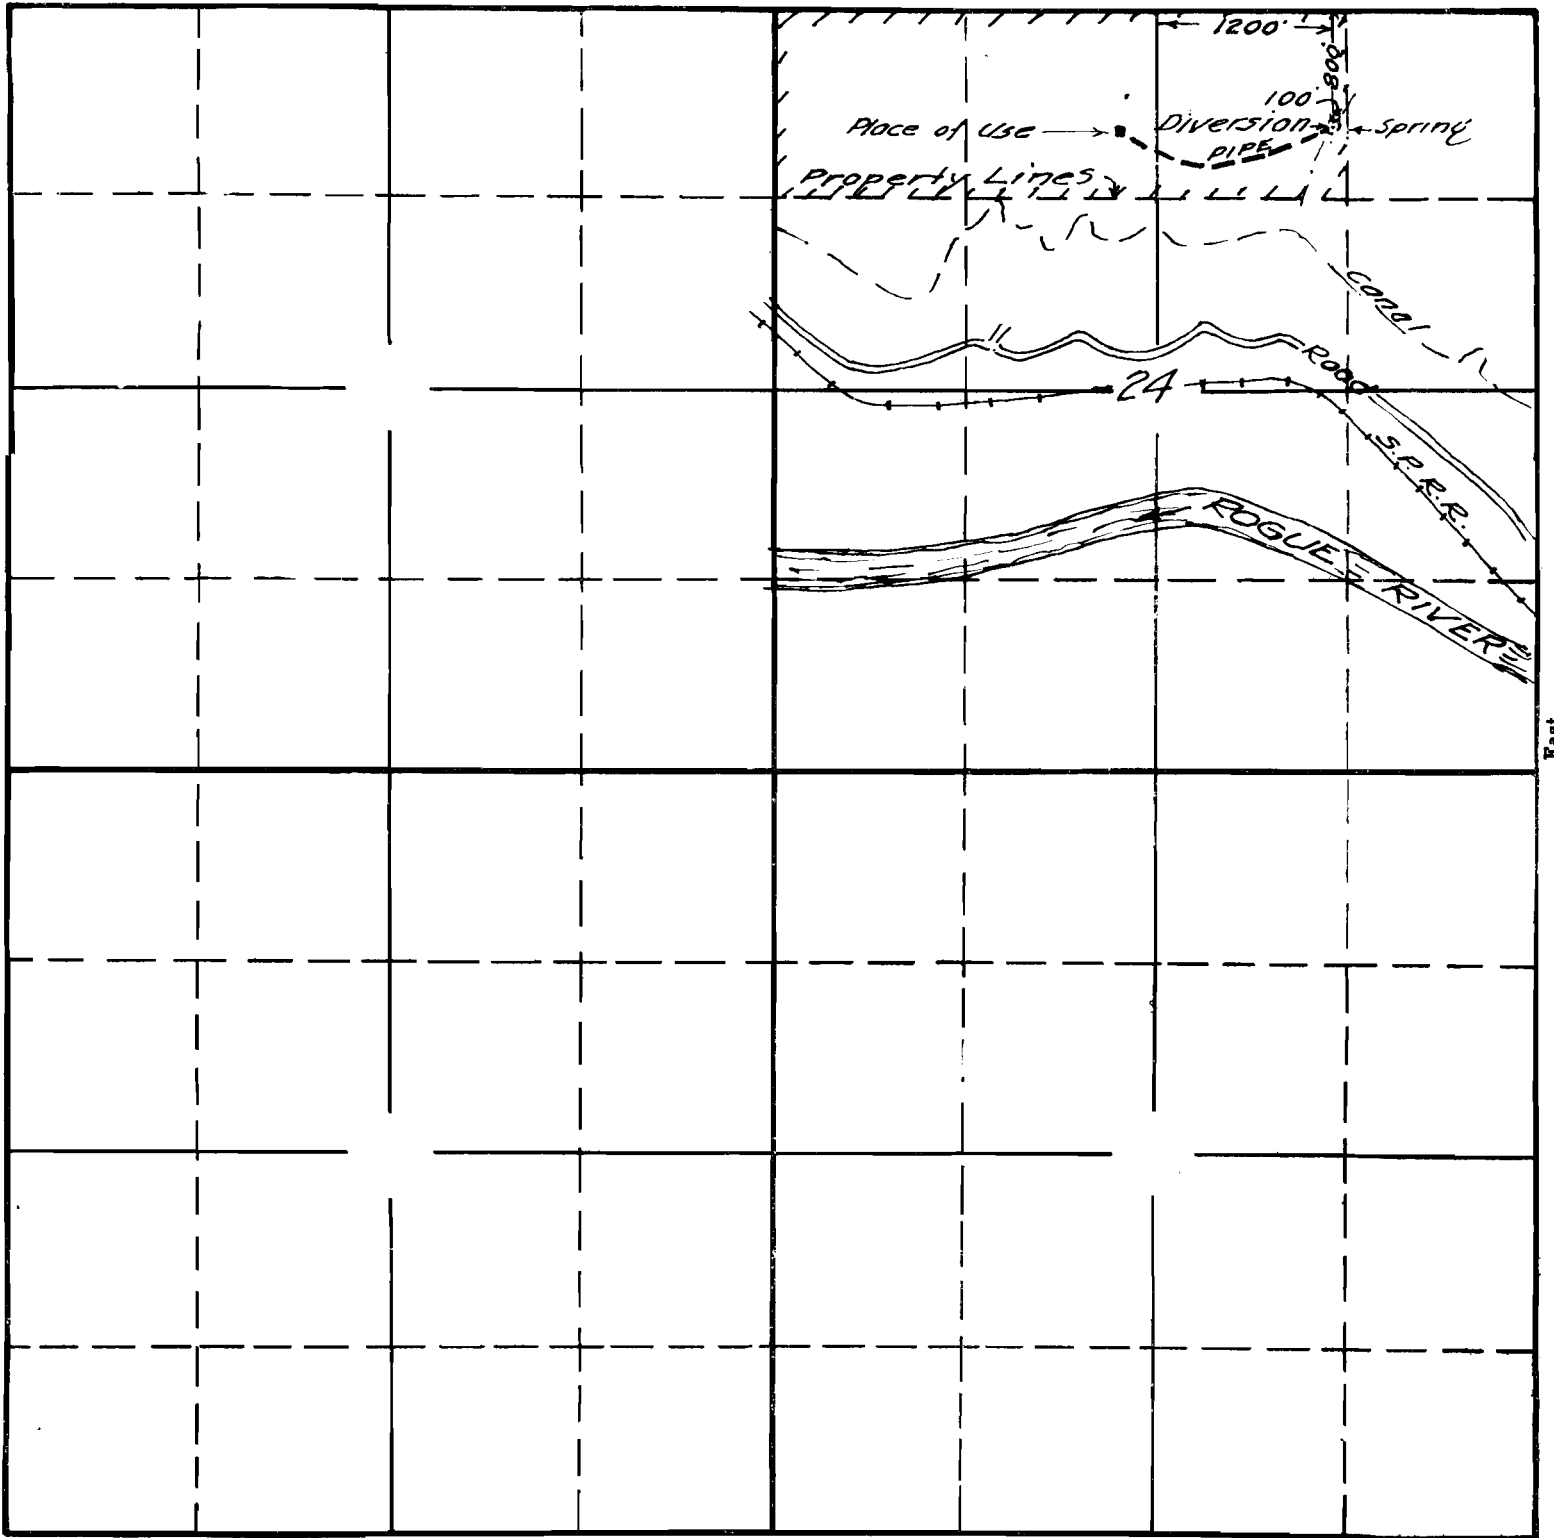

South

*Theodore Hilton Turner*  
*Dec. 1944*

20598  
15-730  
APPLICATION No. 20598  
PERMIT No. 16094