


26

TOWNSHIP 34S, RANGE 3W, W. M.

North

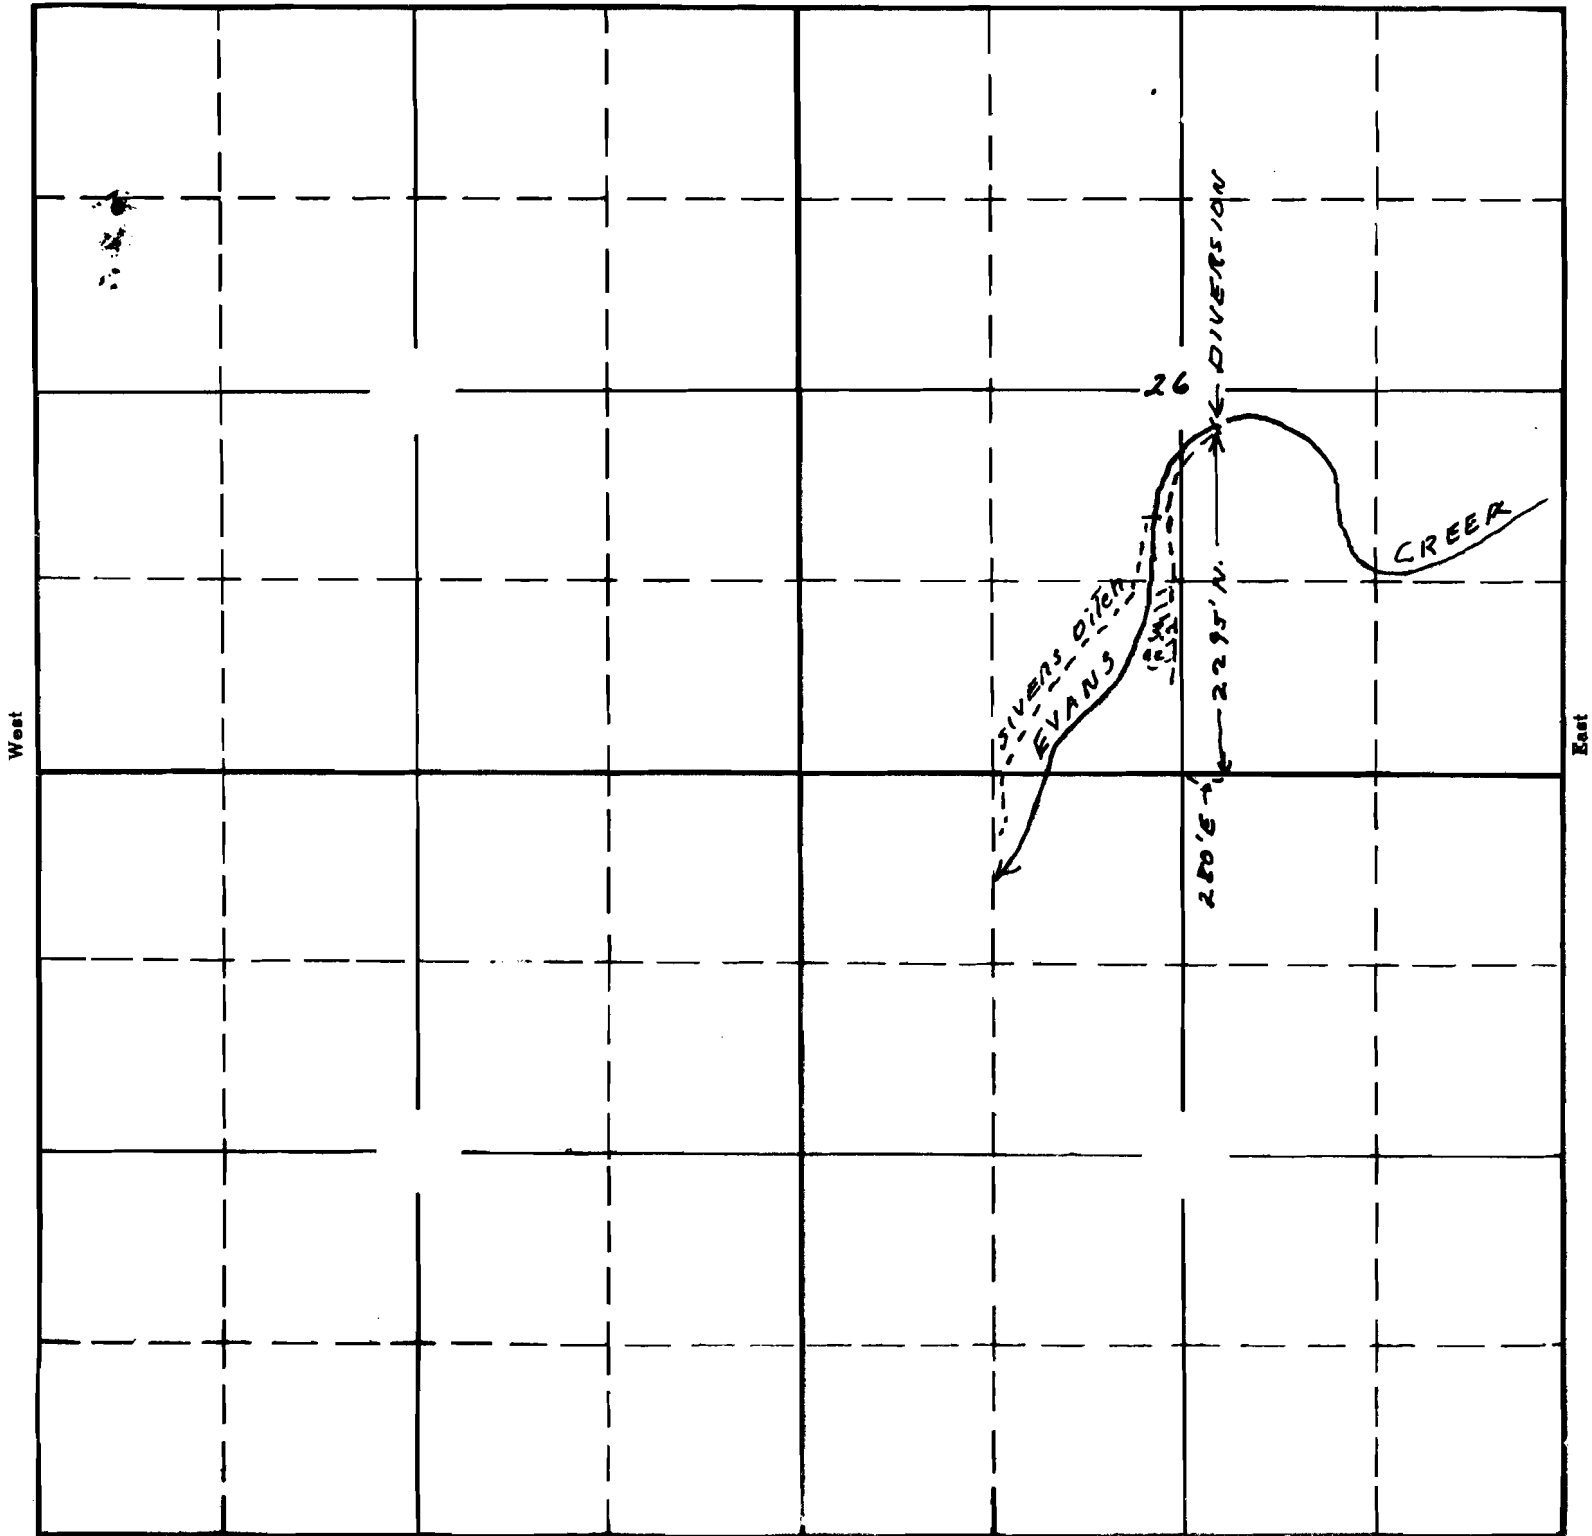

South

Map To accompany application of Alfred J Boulter for use of waters of Evans Creek for irrigation purposes

20620
15-37

APPLICATION No. 20620
PERMIT No. 16105

This office 12/26/14 J. H. G.