


SECTION

4

36 S

TOWNSHIP ~~50 S~~, RANGE ~~8 N~~, W. M.

North

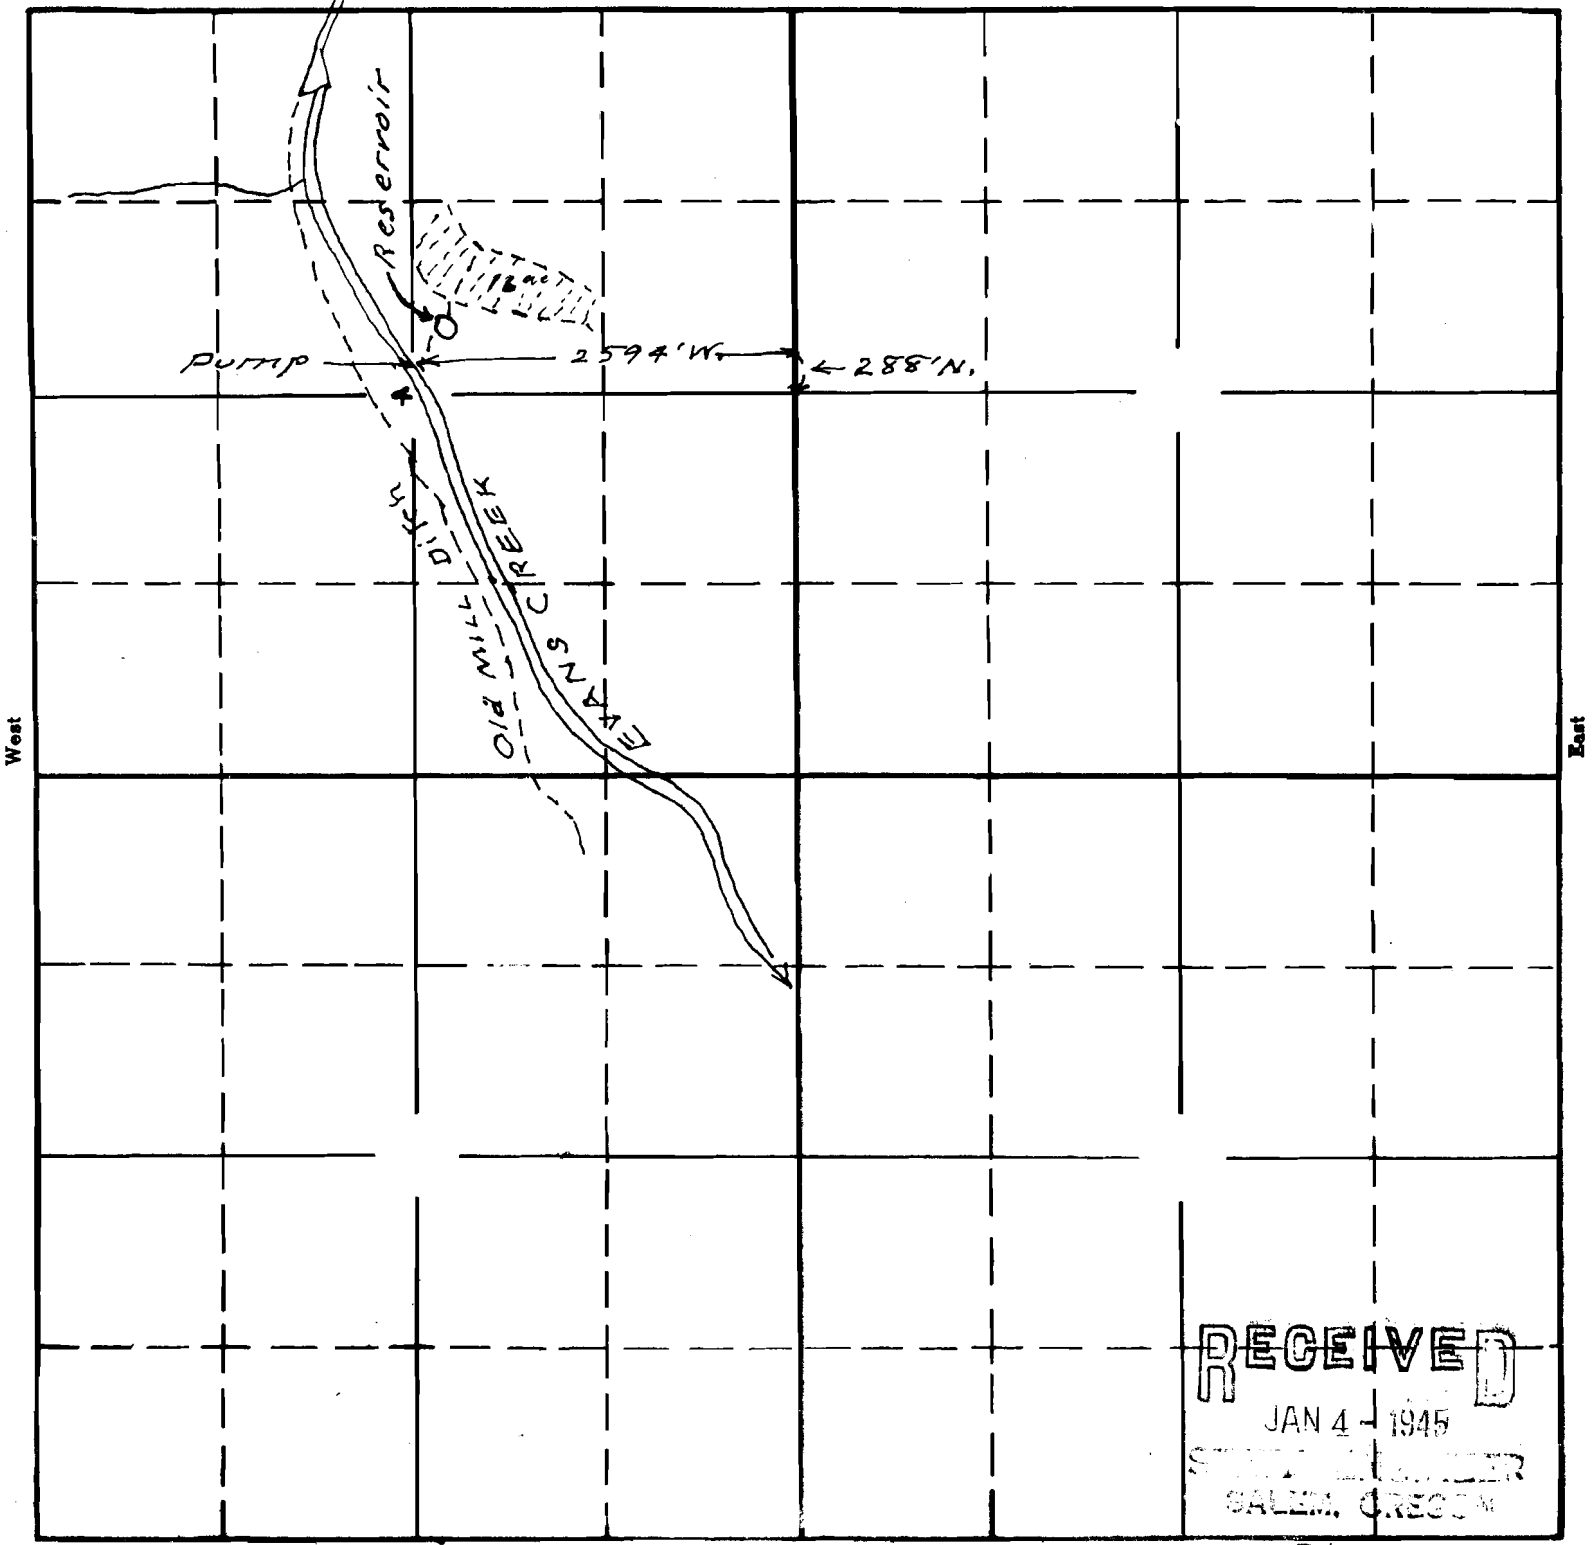

South

**RECEIVED**  
 JAN 4 1945  
 STATE ENGINEER  
 SALEM, OREGON

20629  
1537

APPLICATION No. 20629  
PERMIT No. 16135

To accompany application of Jay Porter  
for storage reservoir for irrigation  
purposes

This office 12/23/44 *[Signature]*