


32

TOWNSHIP 32 S, RANGE 3 E, W. M.

North

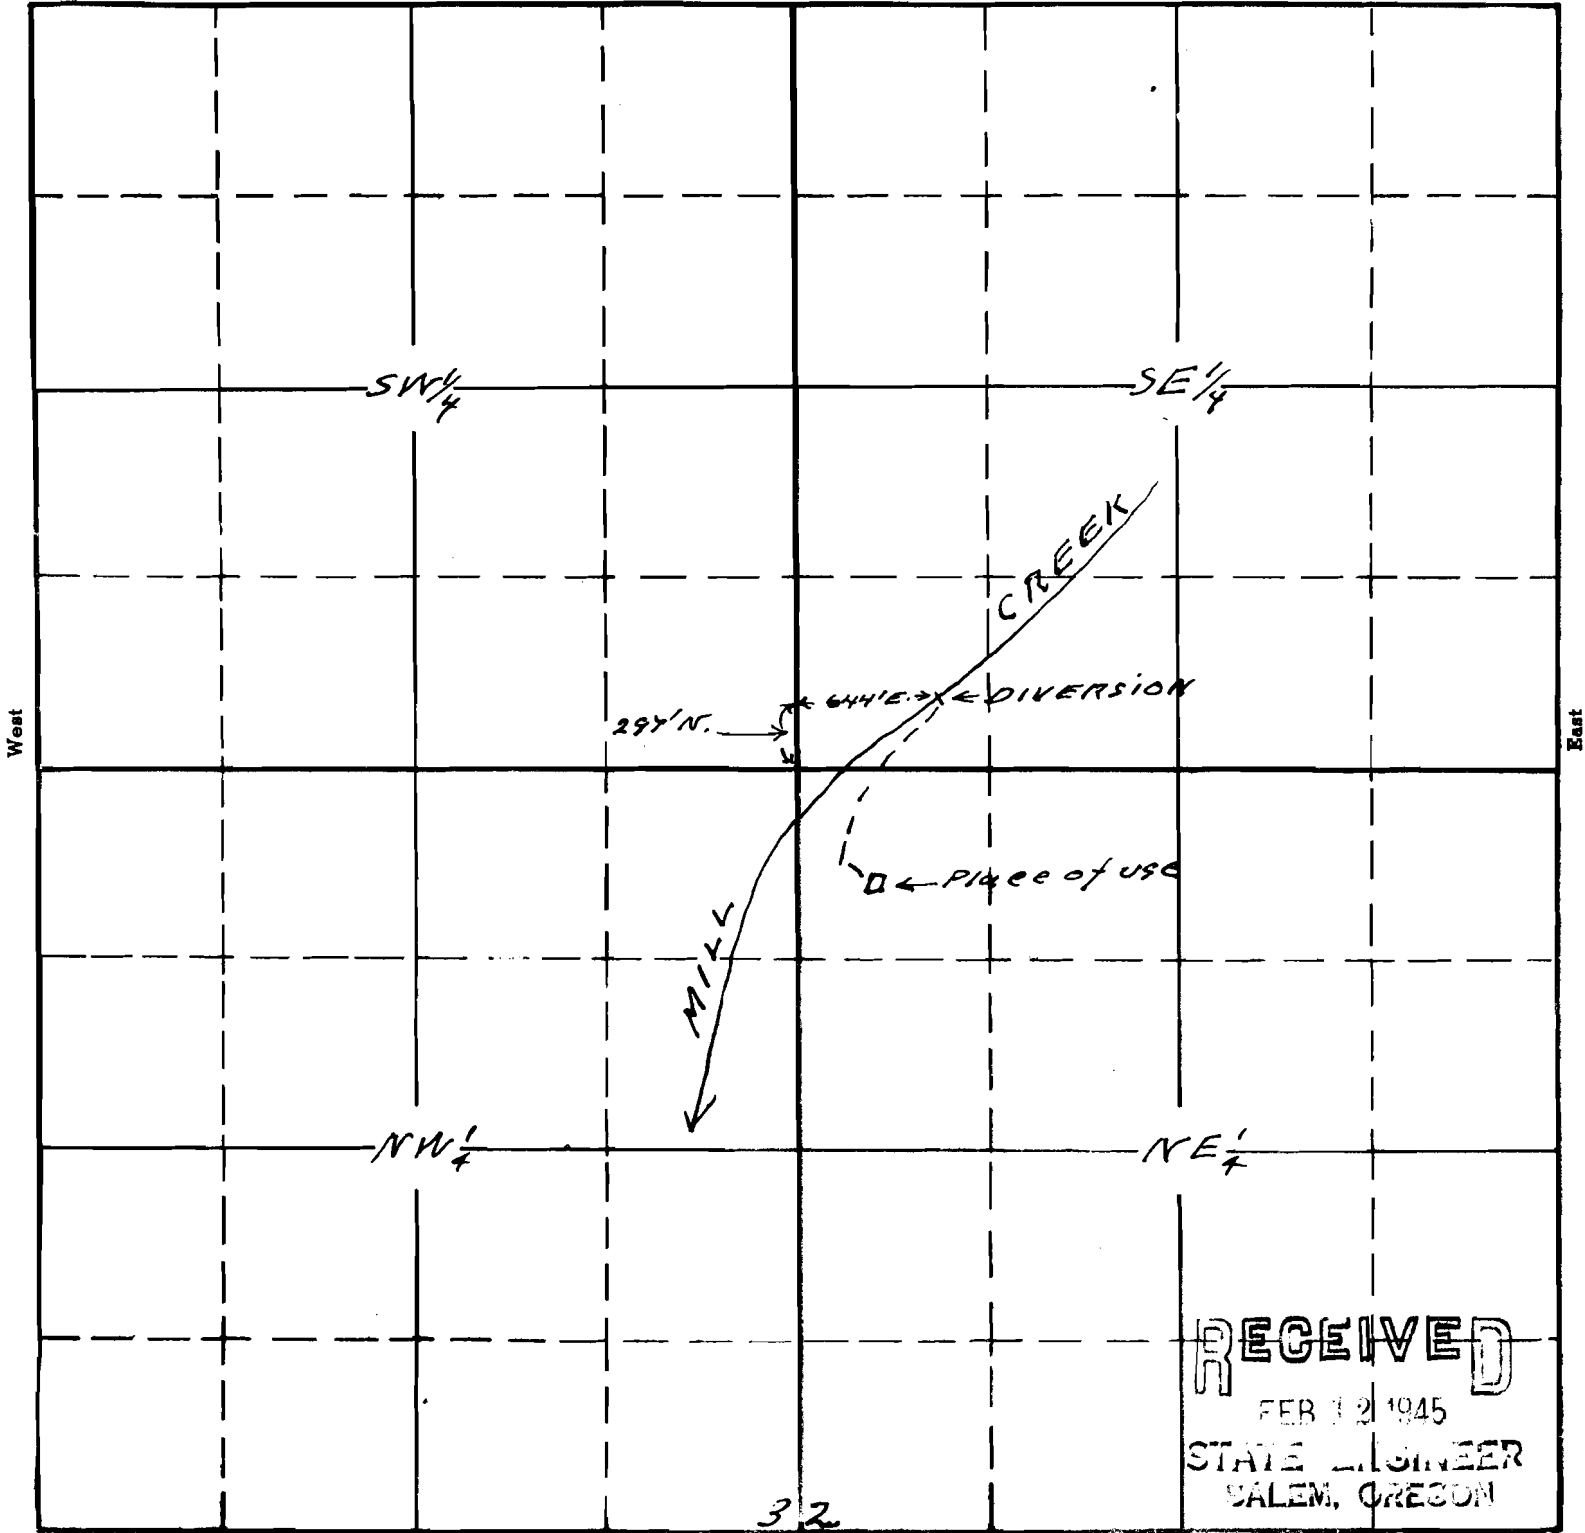

RECEIVED
 FEB 12 1945
 STATE ENGINEER
 SALEM, OREGON

32

South

Map to accompany application of
 W.E. Mooney for use of waters of
 Mill Creek for domestic purposes

20682
 15-780
 APPLICATION No. 20682
 PERMIT No. 16179

This office 2/8/45 *[Signature]*