


Sec.

Tp. 38 S  

Permit: S 16214  
Volume: 8A  
Strm: UNN STR  
Trib: WHITE CR>DEER CR  
Priority: 1/12/44

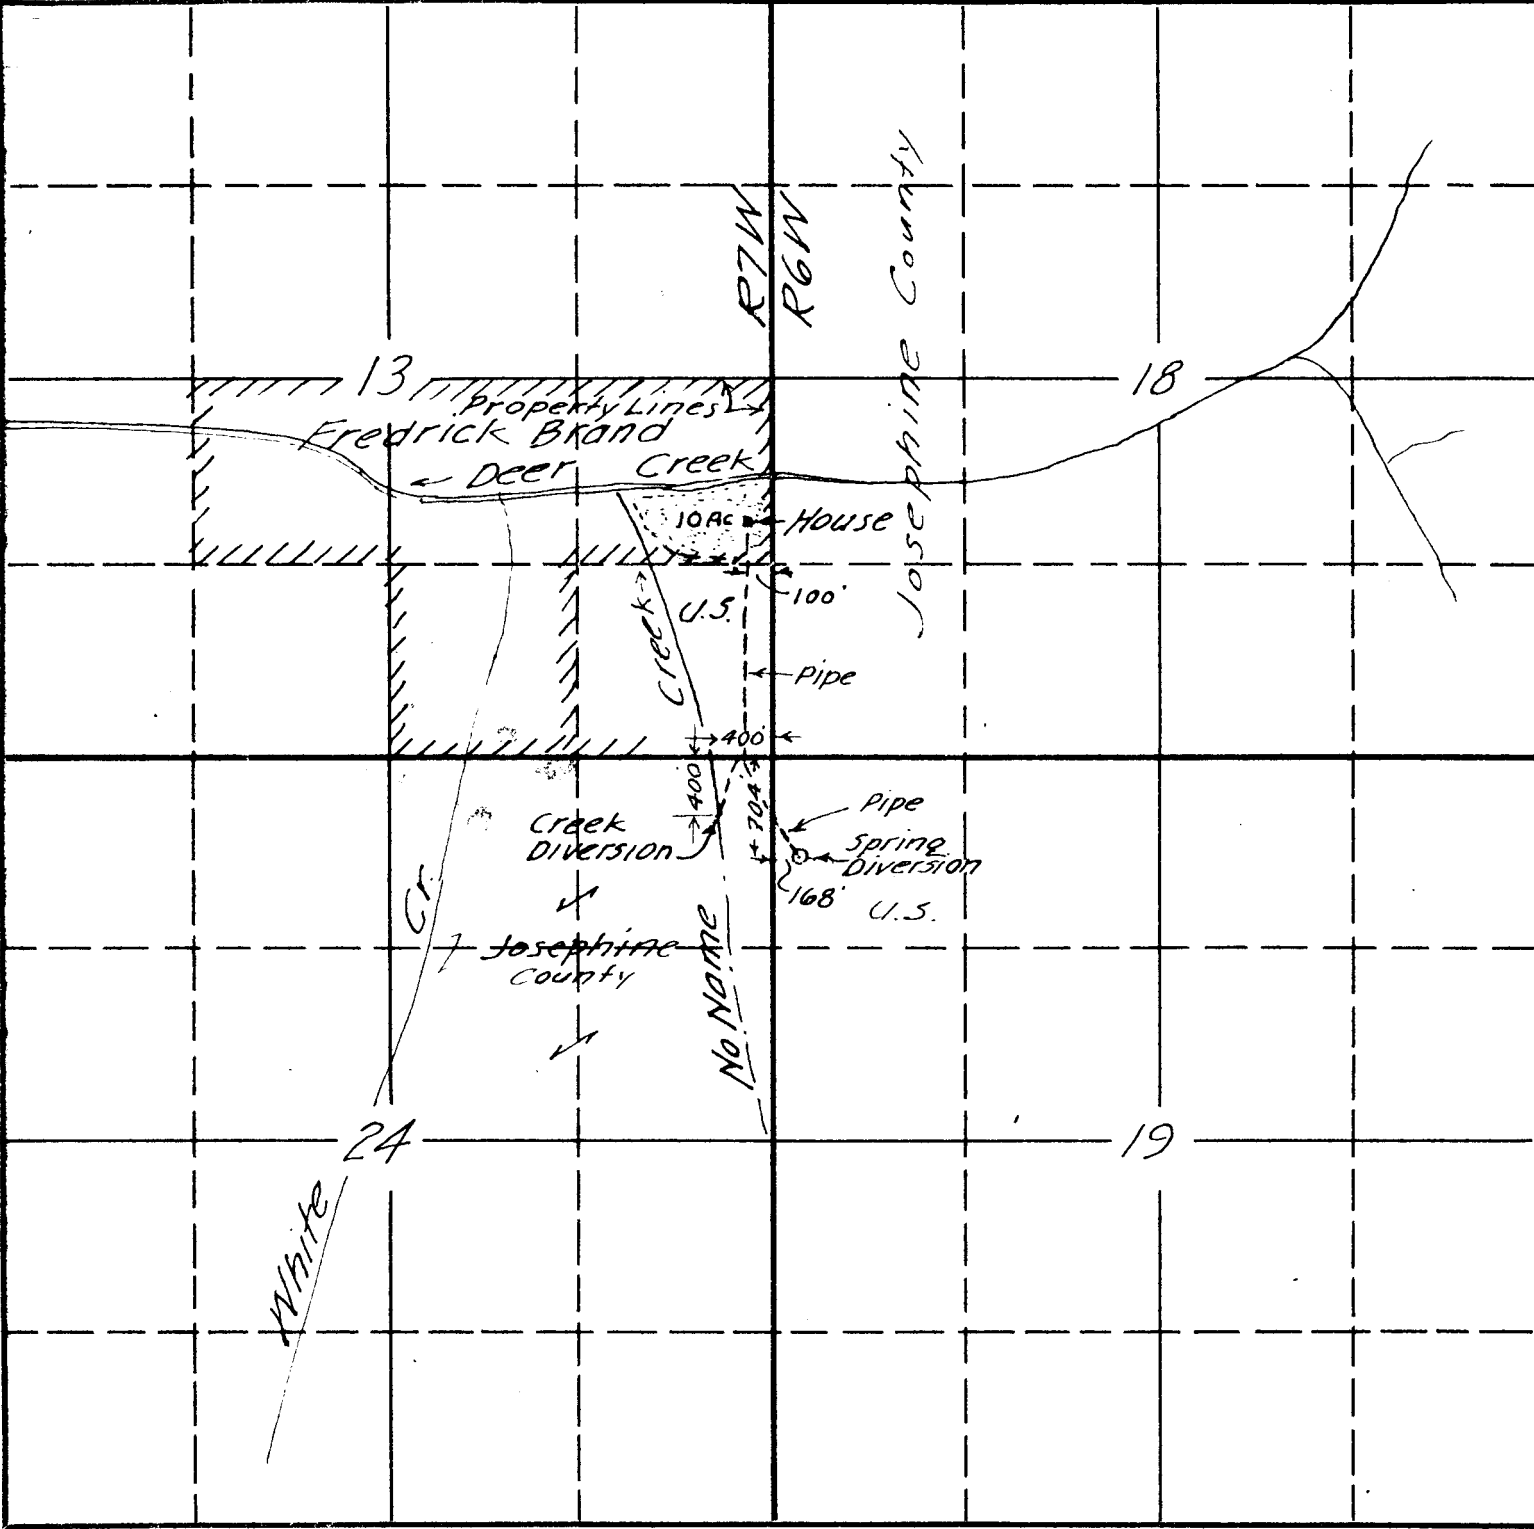

Fredrick Brand  
Jan 1944

20121 01

Application No 20121  
Permit No 16214