

Permit: S 16346
Volume: 8A
Stem: W FK ILLINOIS R
Trib: ILLINOIS R
Priority: 5/24/45

Sec.


1

32

Tp. 39 S.

R. 8 W.

N.M.

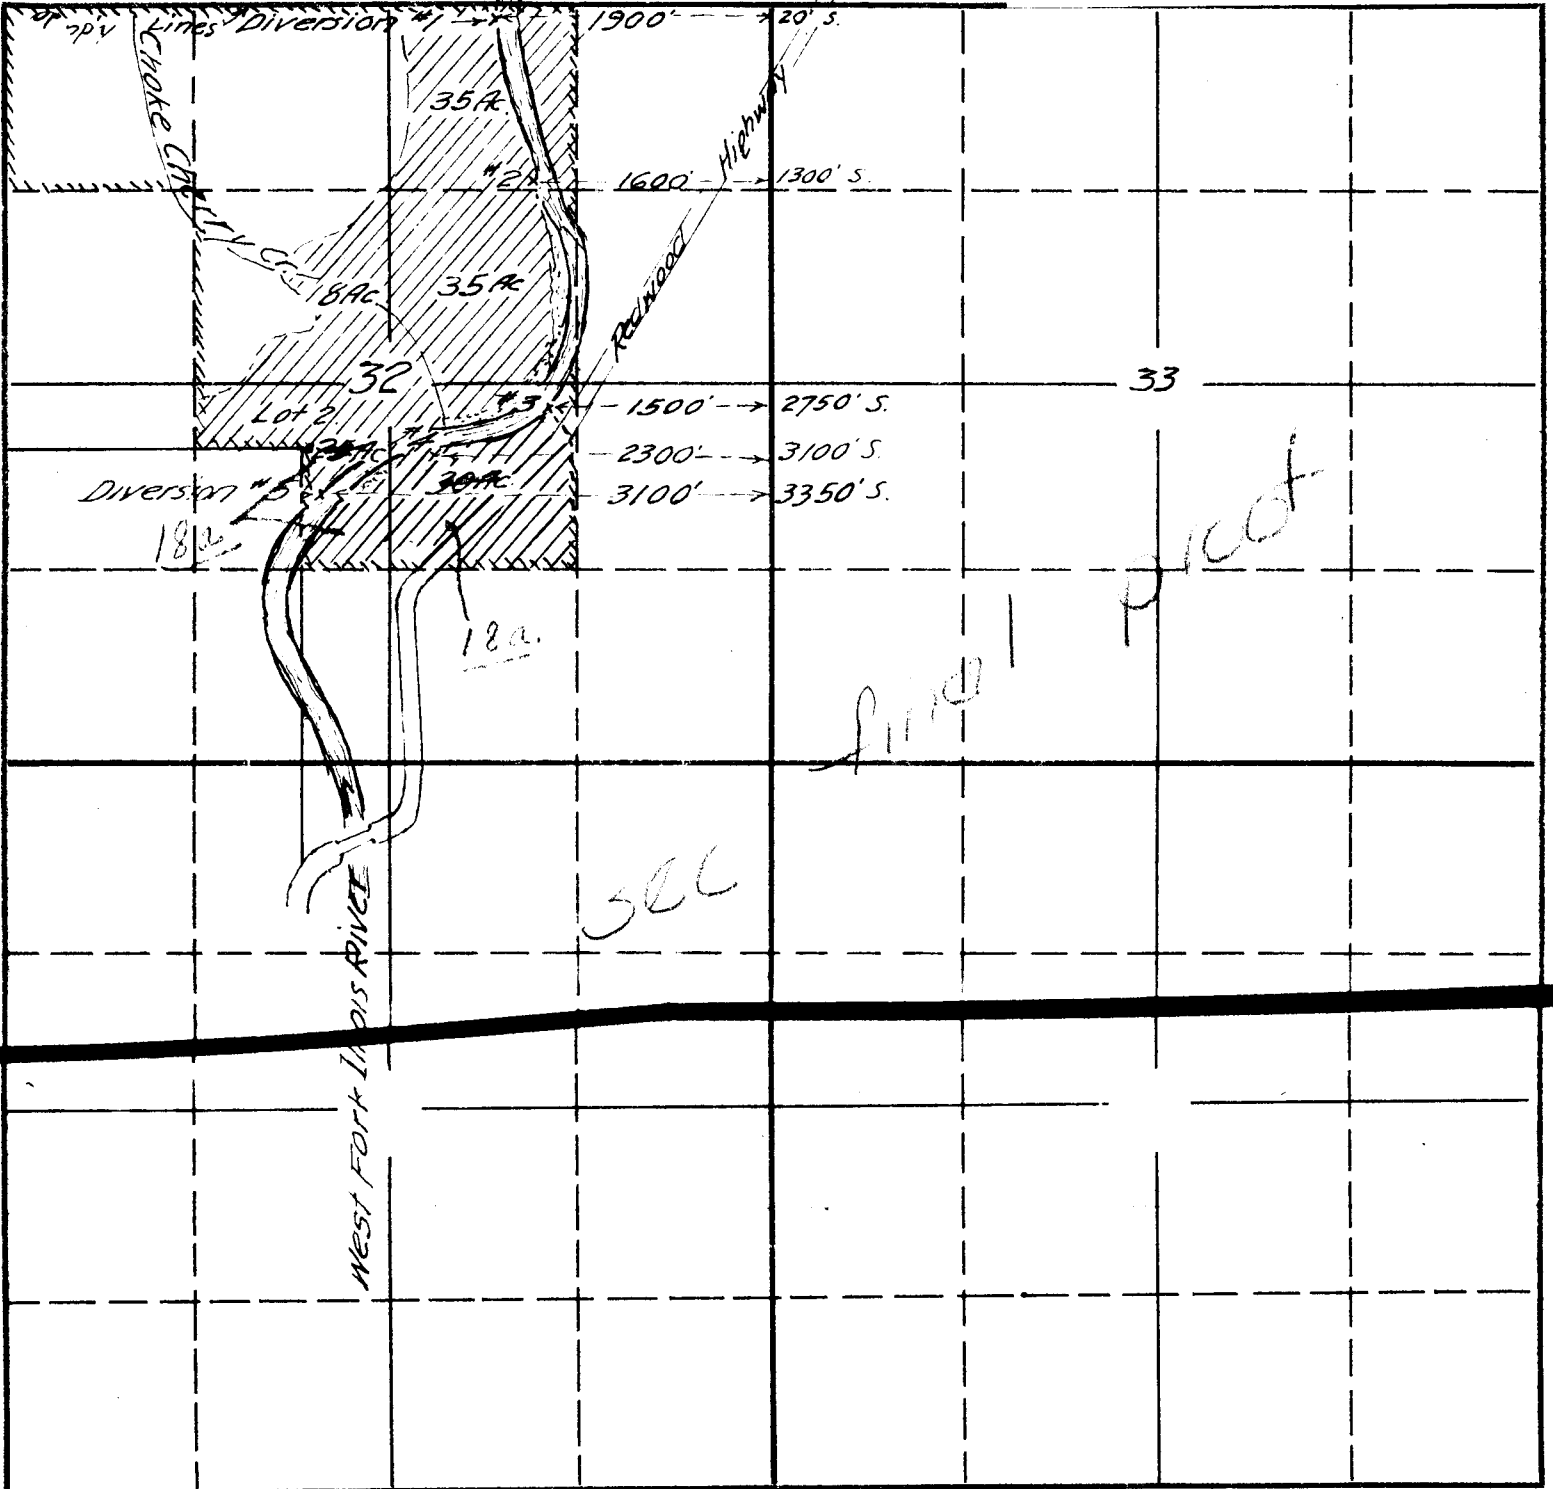

W.O. Burch
May 1945.

20870 15000
Application No. 20870
Permit No. 16346