


Permit: S 16397  
Volume: 6  
Strm: APLEGATE R  
Trib: ROGUE R  
Priority: 7/05/45

Sec.

Tp. 37

R 6 W

N. M.

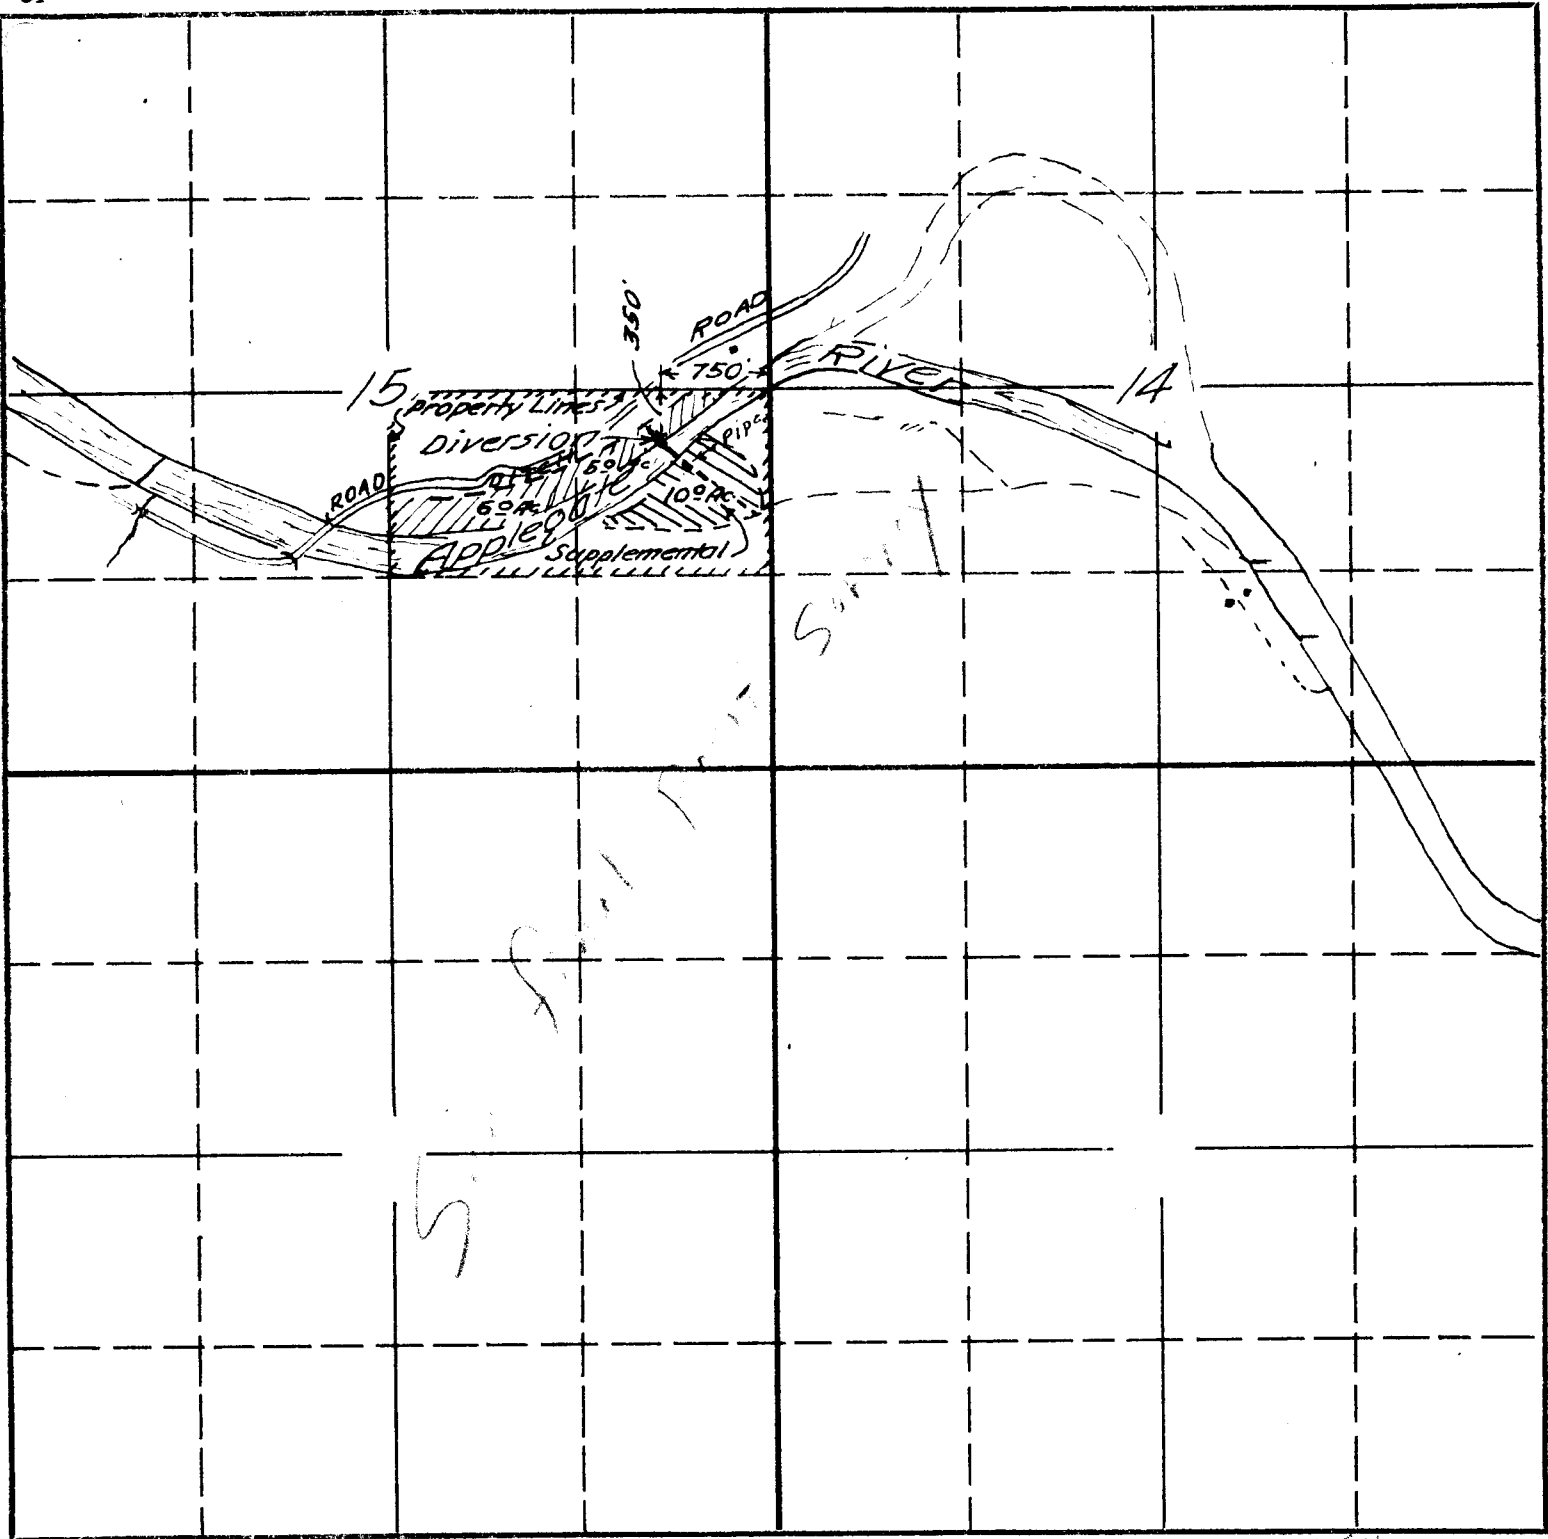

20940

William H. Morgan Application No. 20940  
July 1945 Permit No. 16397