

Sec.

31


32

Tp. 35 S.

R. 6 W.

N.M.

Permit: S 16434  
Volume: 5  
Strm: W FK EWE CR  
Trib: EWE CR  
Priority: 7/20/45

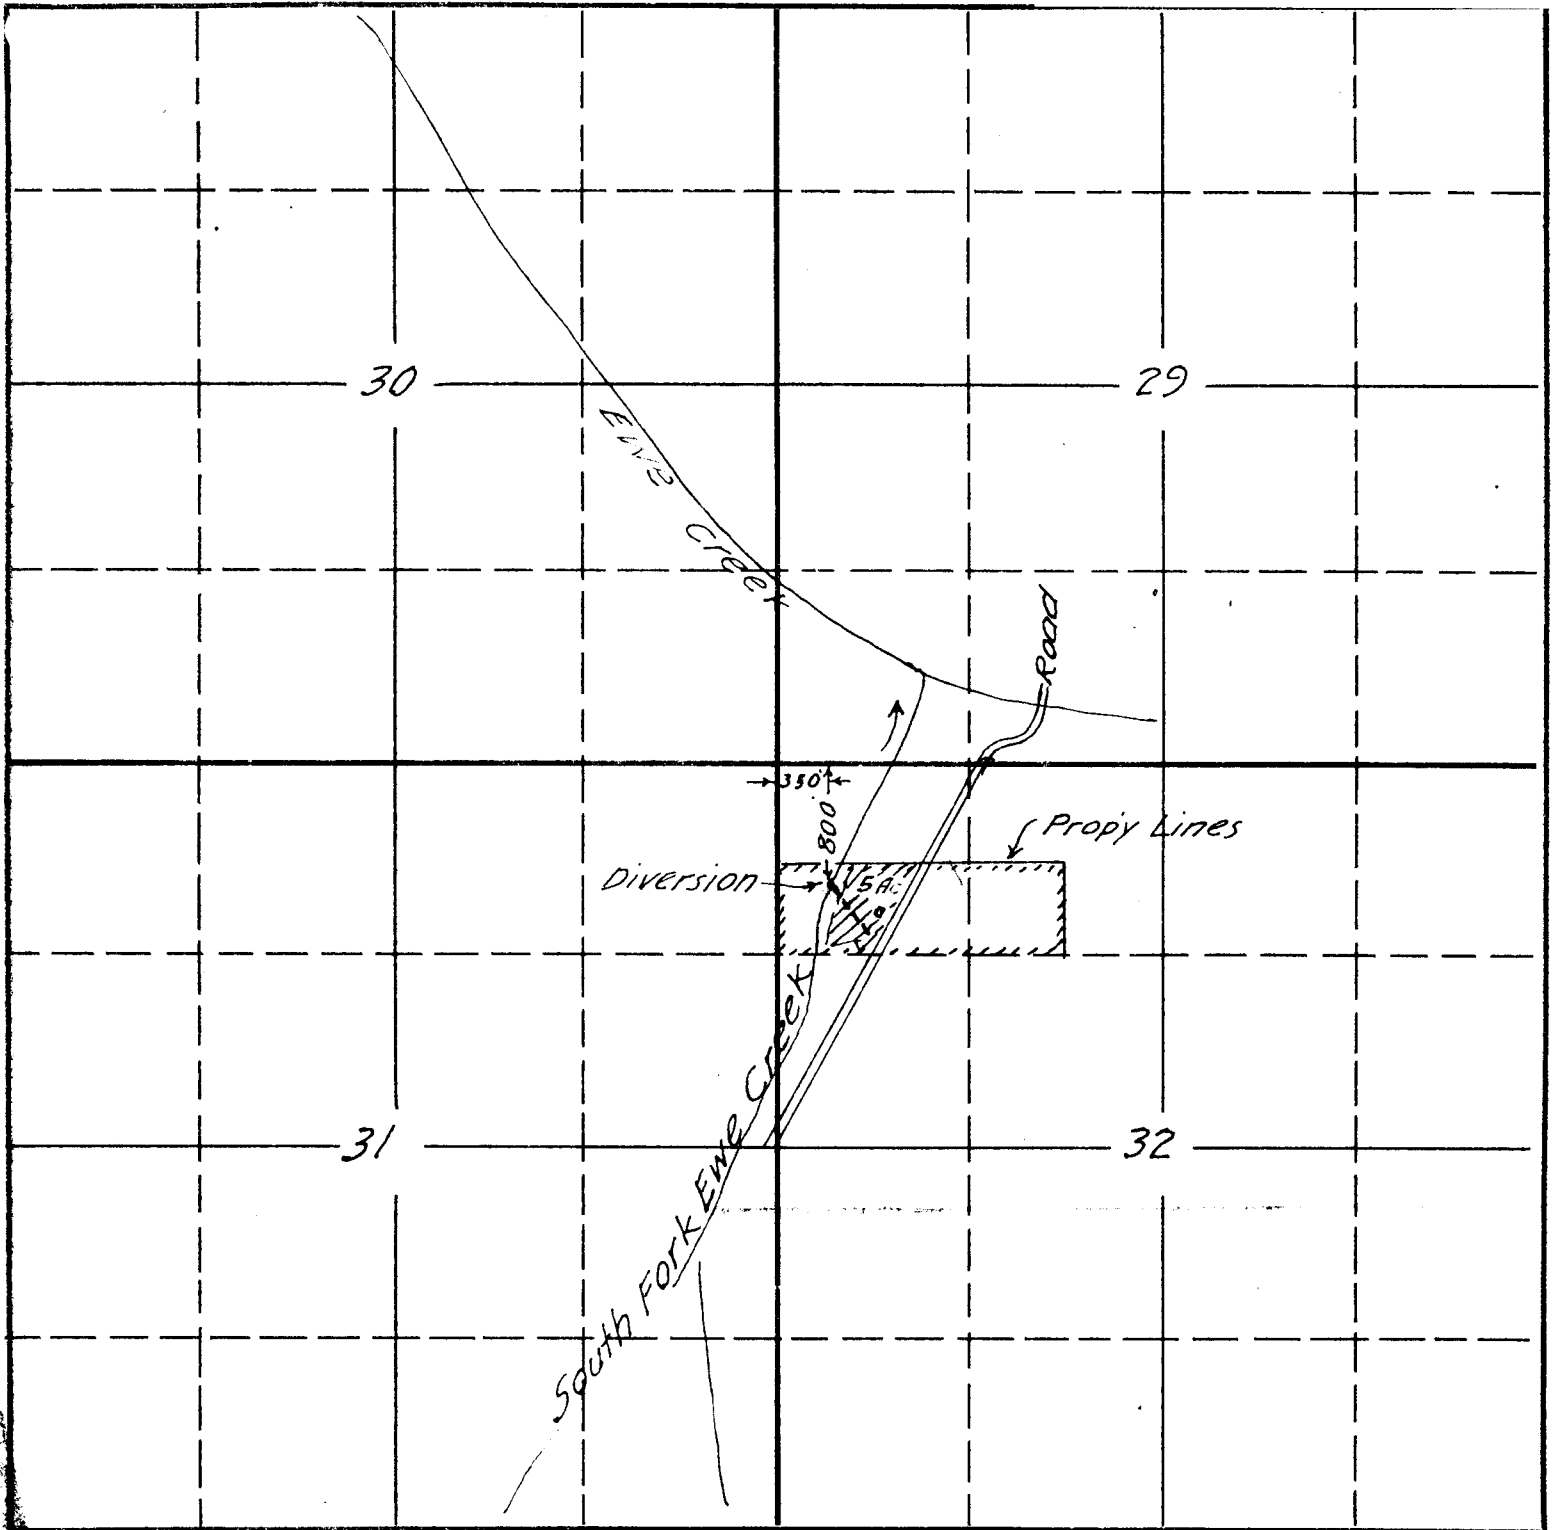

Charlotte T. West  
July 1945

Application No 20995  
Permit No .....  
16434