


27

TOWNSHIP 39 S, RANGE 2 W, W. M.

North

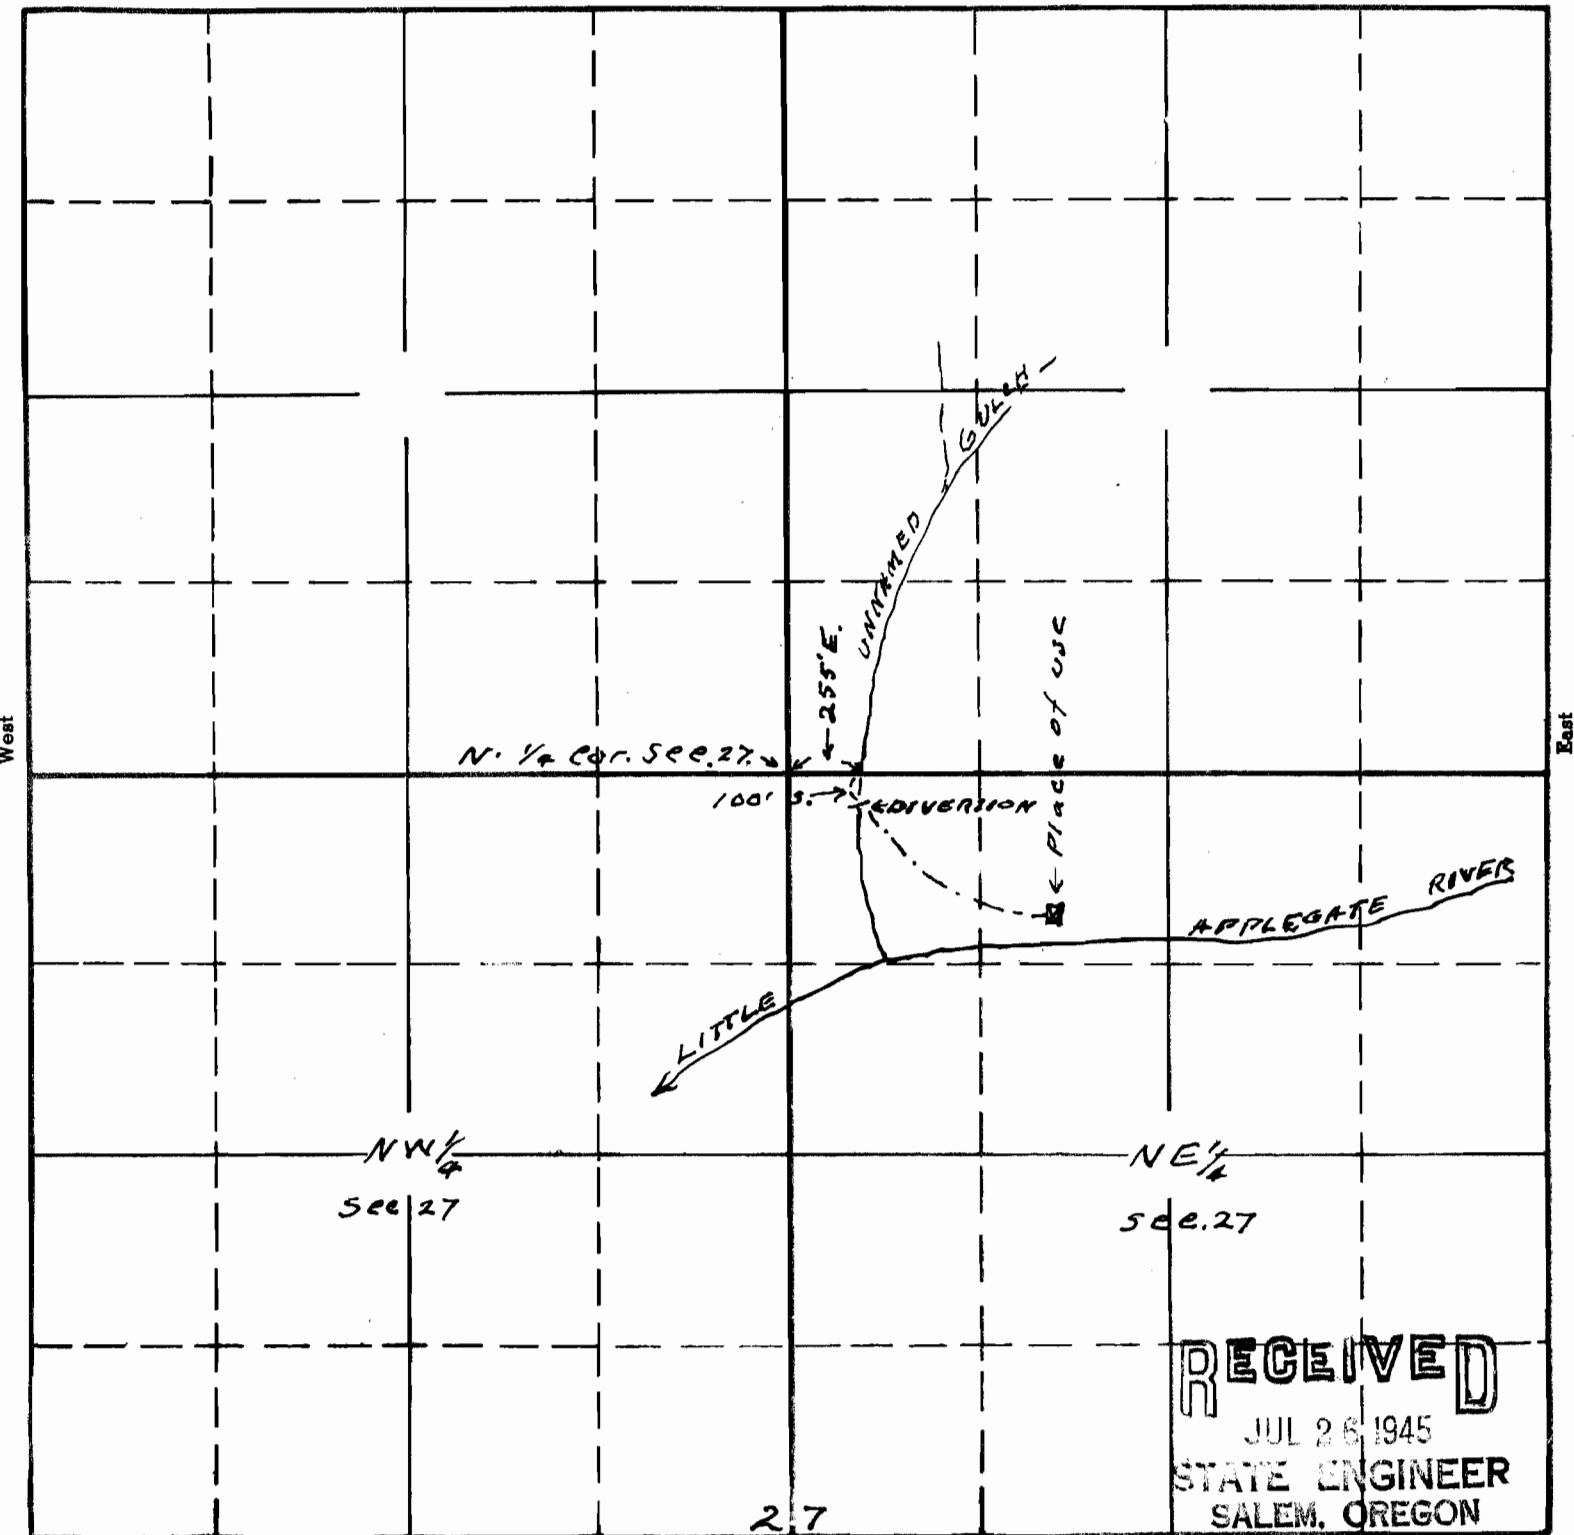

NW 1/4  
Sec. 27

NE 1/4  
Sec. 27

27

South

**RECEIVED**  
 JUL 26 1945  
 STATE ENGINEER  
 SALEM, OREGON

21026  
15-160

APPLICATION No. 21026  
PERMIT No. 16447

Map to accompany application of Earl T White for use of water from Unnamed gulch for domestic purposes.

This office 7/18/45 J. Smith