


T. 32 S., R. 4 W

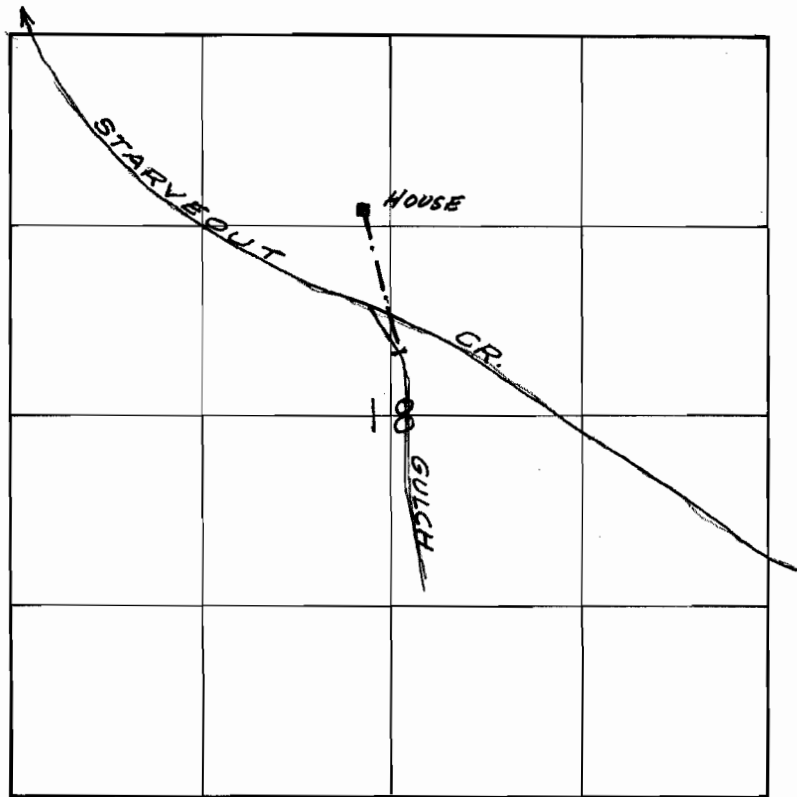


sketched from app. map.

SECTION

18

TOWNSHIP 32 S, RANGE 4 W, W. M.

North

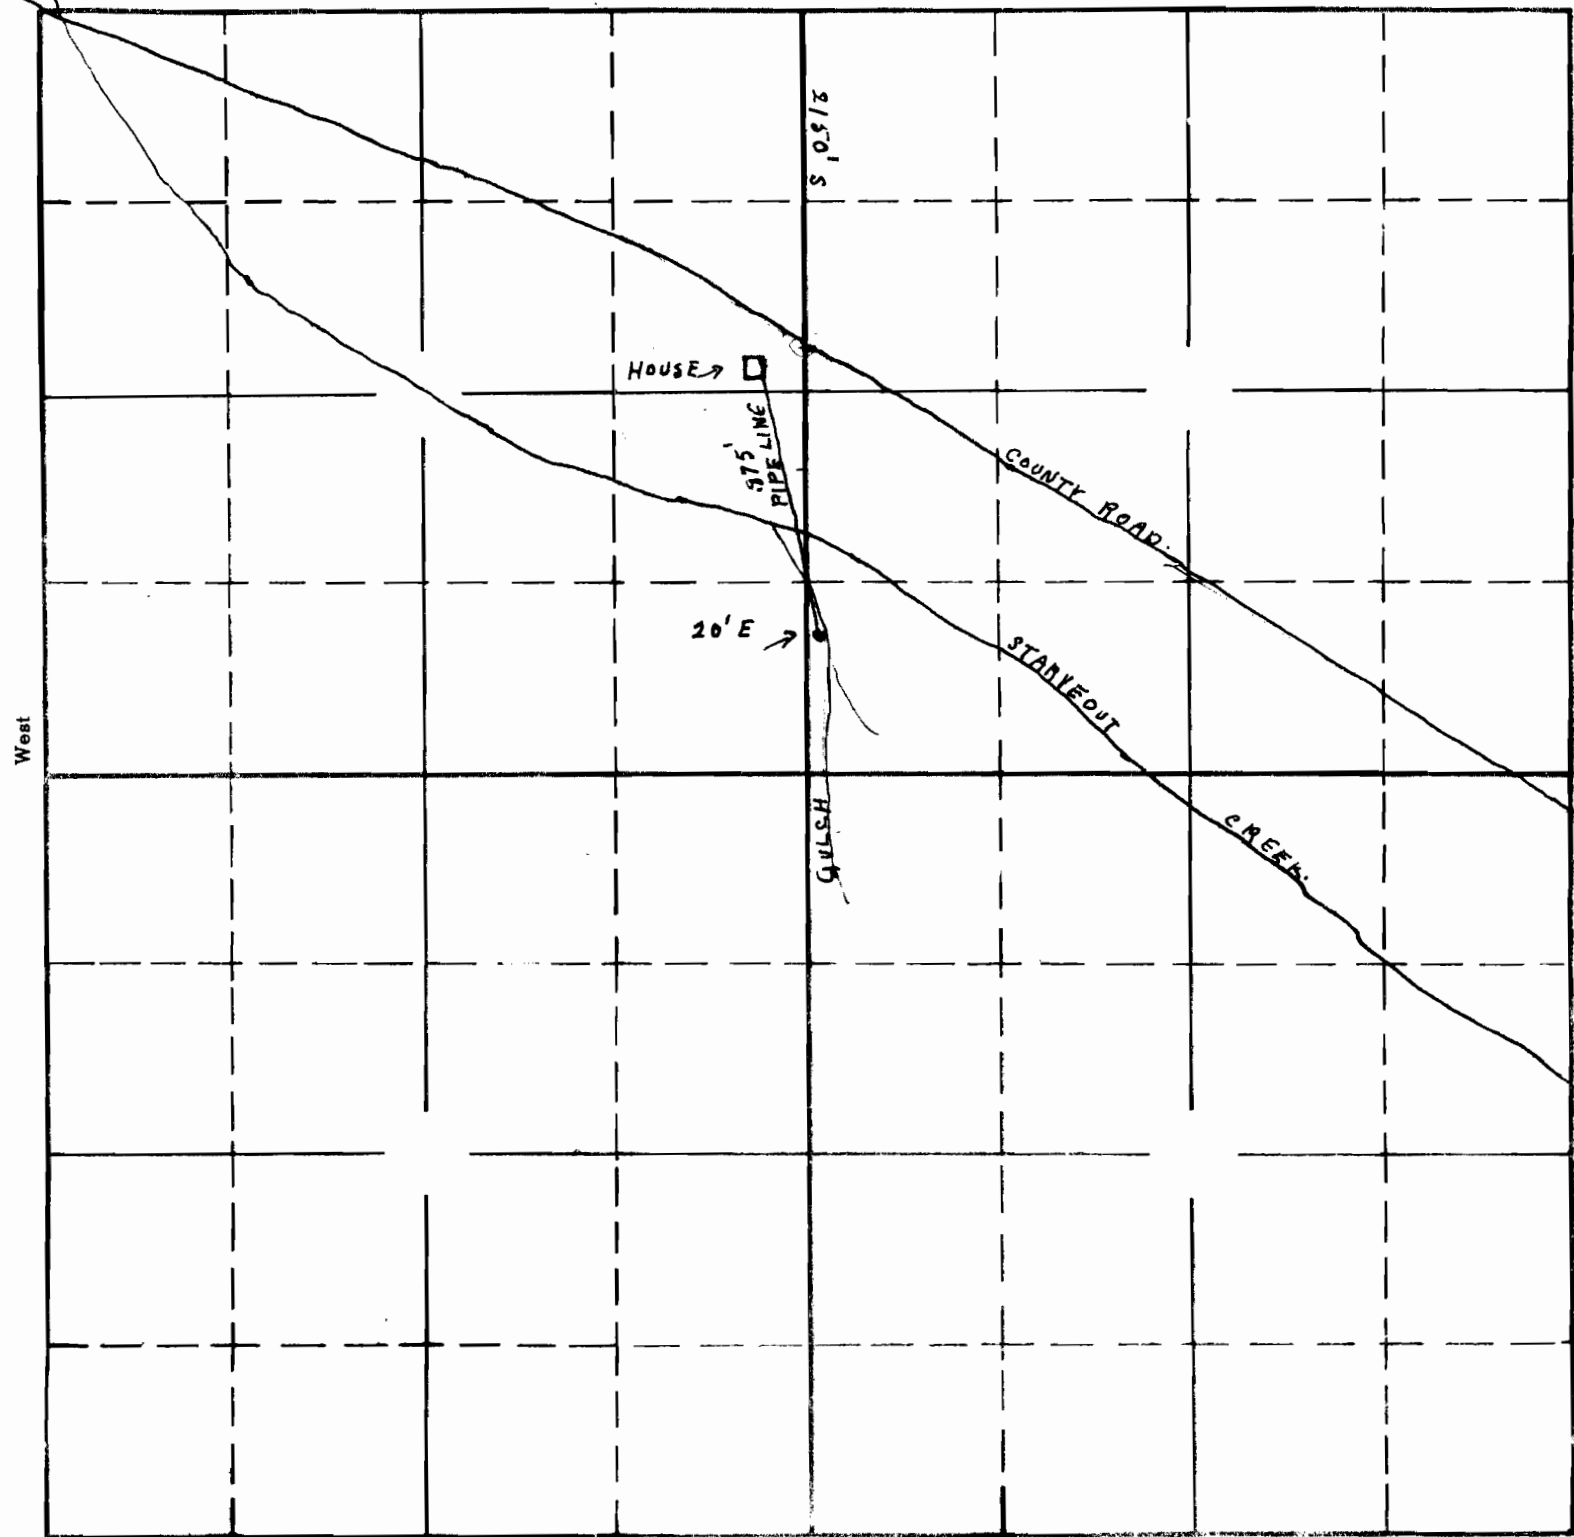

South

21029
 APPLICATION No. 21029
 PERMIT No. 16450

RECEIVED

JUL 9 1921

STATE ENGINEER
 SALEM, OREGON