


# T.4S.R.2W.W.M.

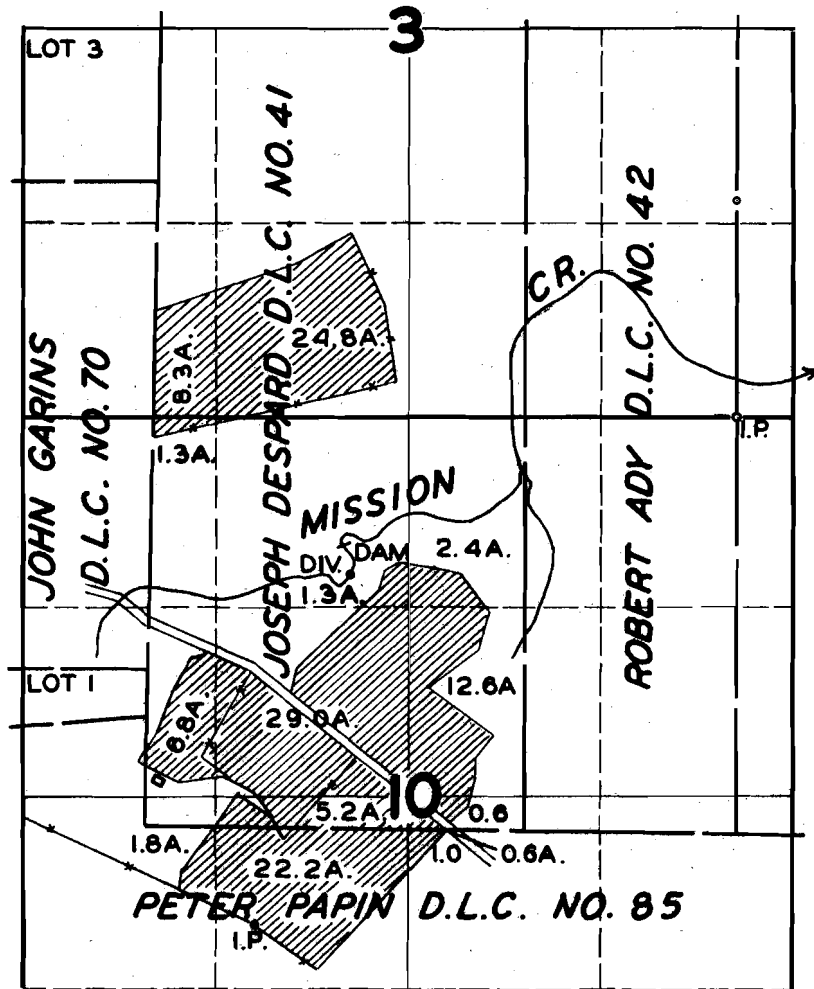

## FINAL PROOF SURVEY

UNDER

20873

16463

Application No. R-20874 Permit No. R-820

IN NAME OF

F. T. WILCOX

Surveyed SEP. 16, 1948, by JAS. E. BUNNELL