


3057
3058
3059
3060


GREEN HORN MOUNTAINS.

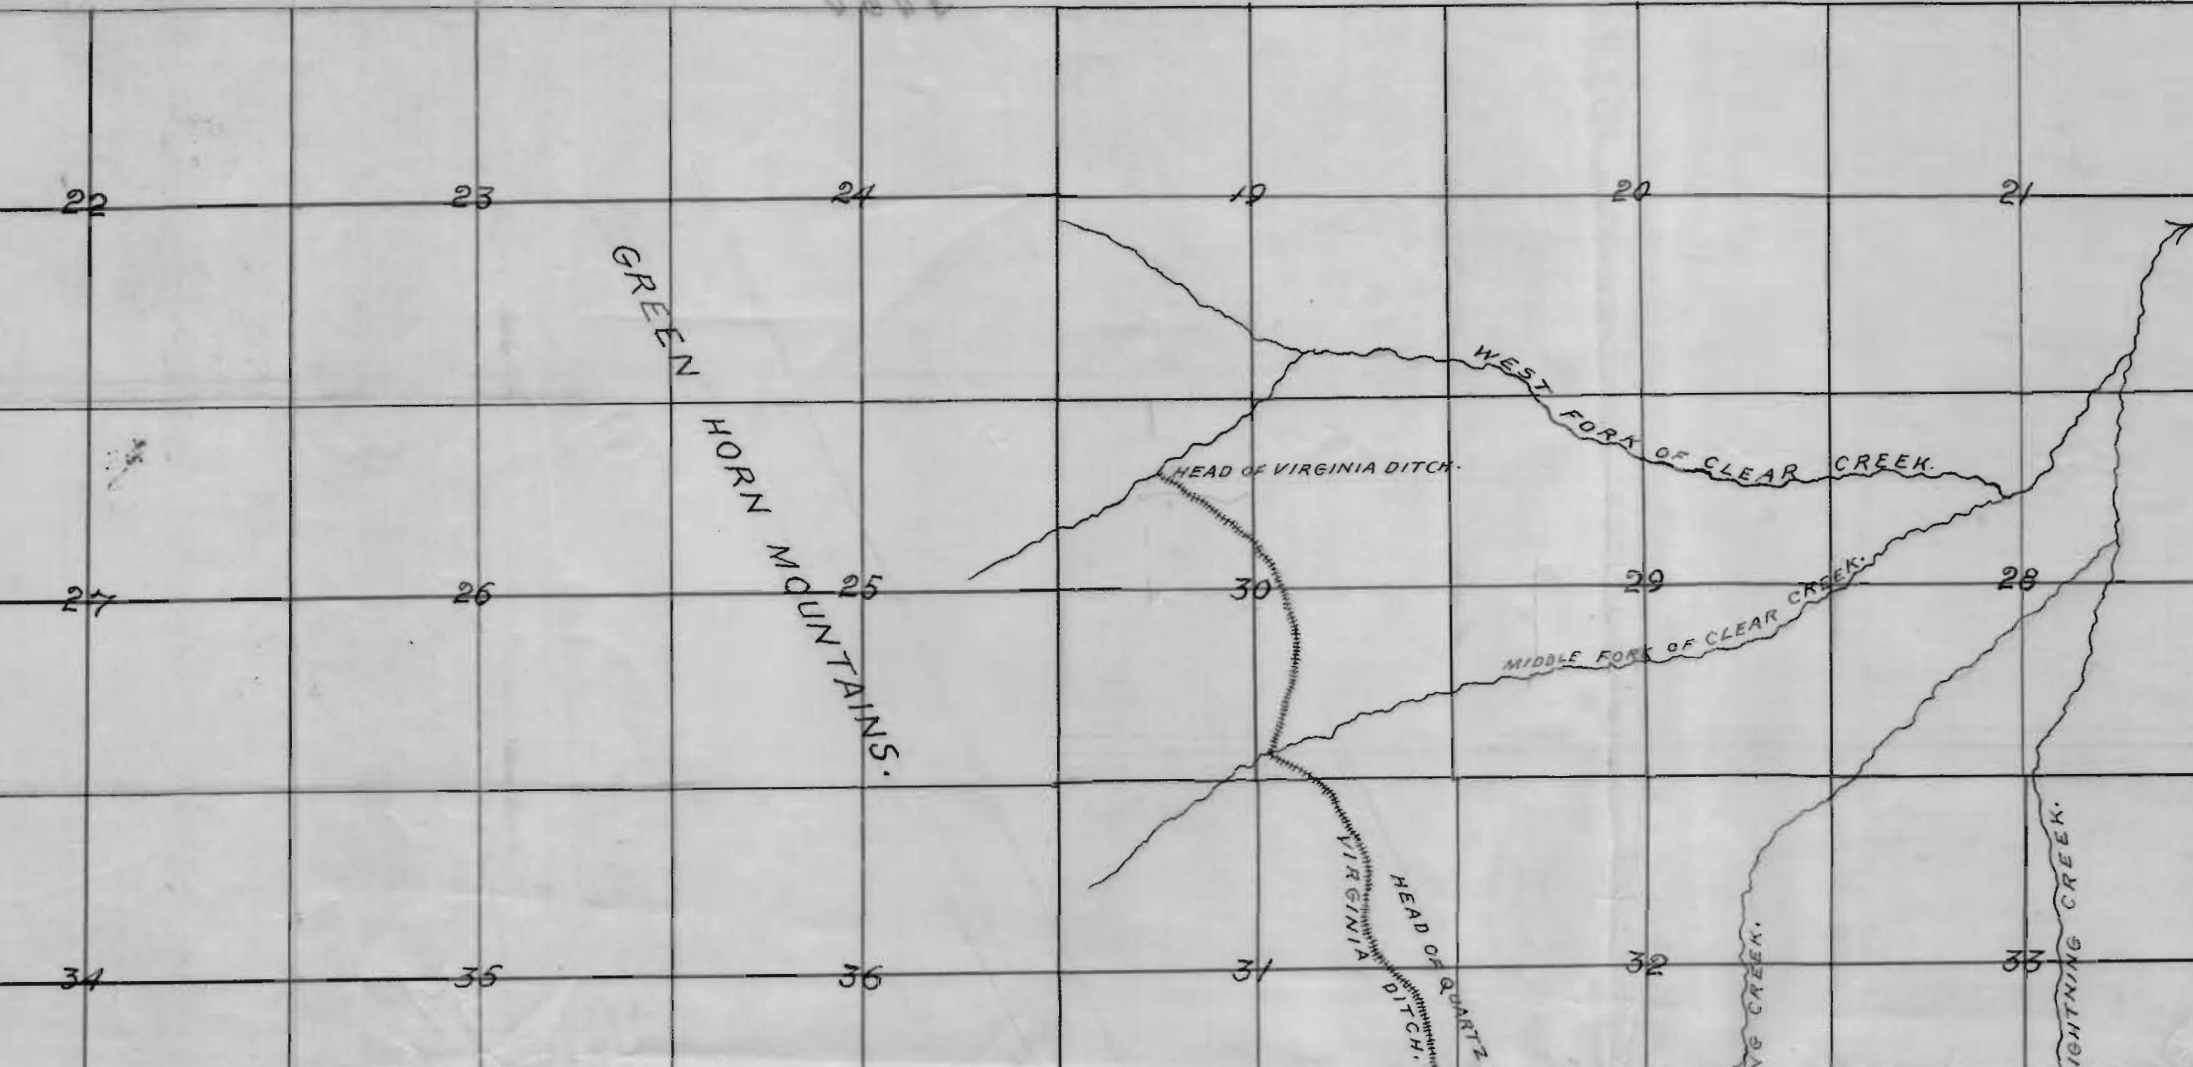

GRANT COUNTY

COUNTY LINE

BAKER COUNTY

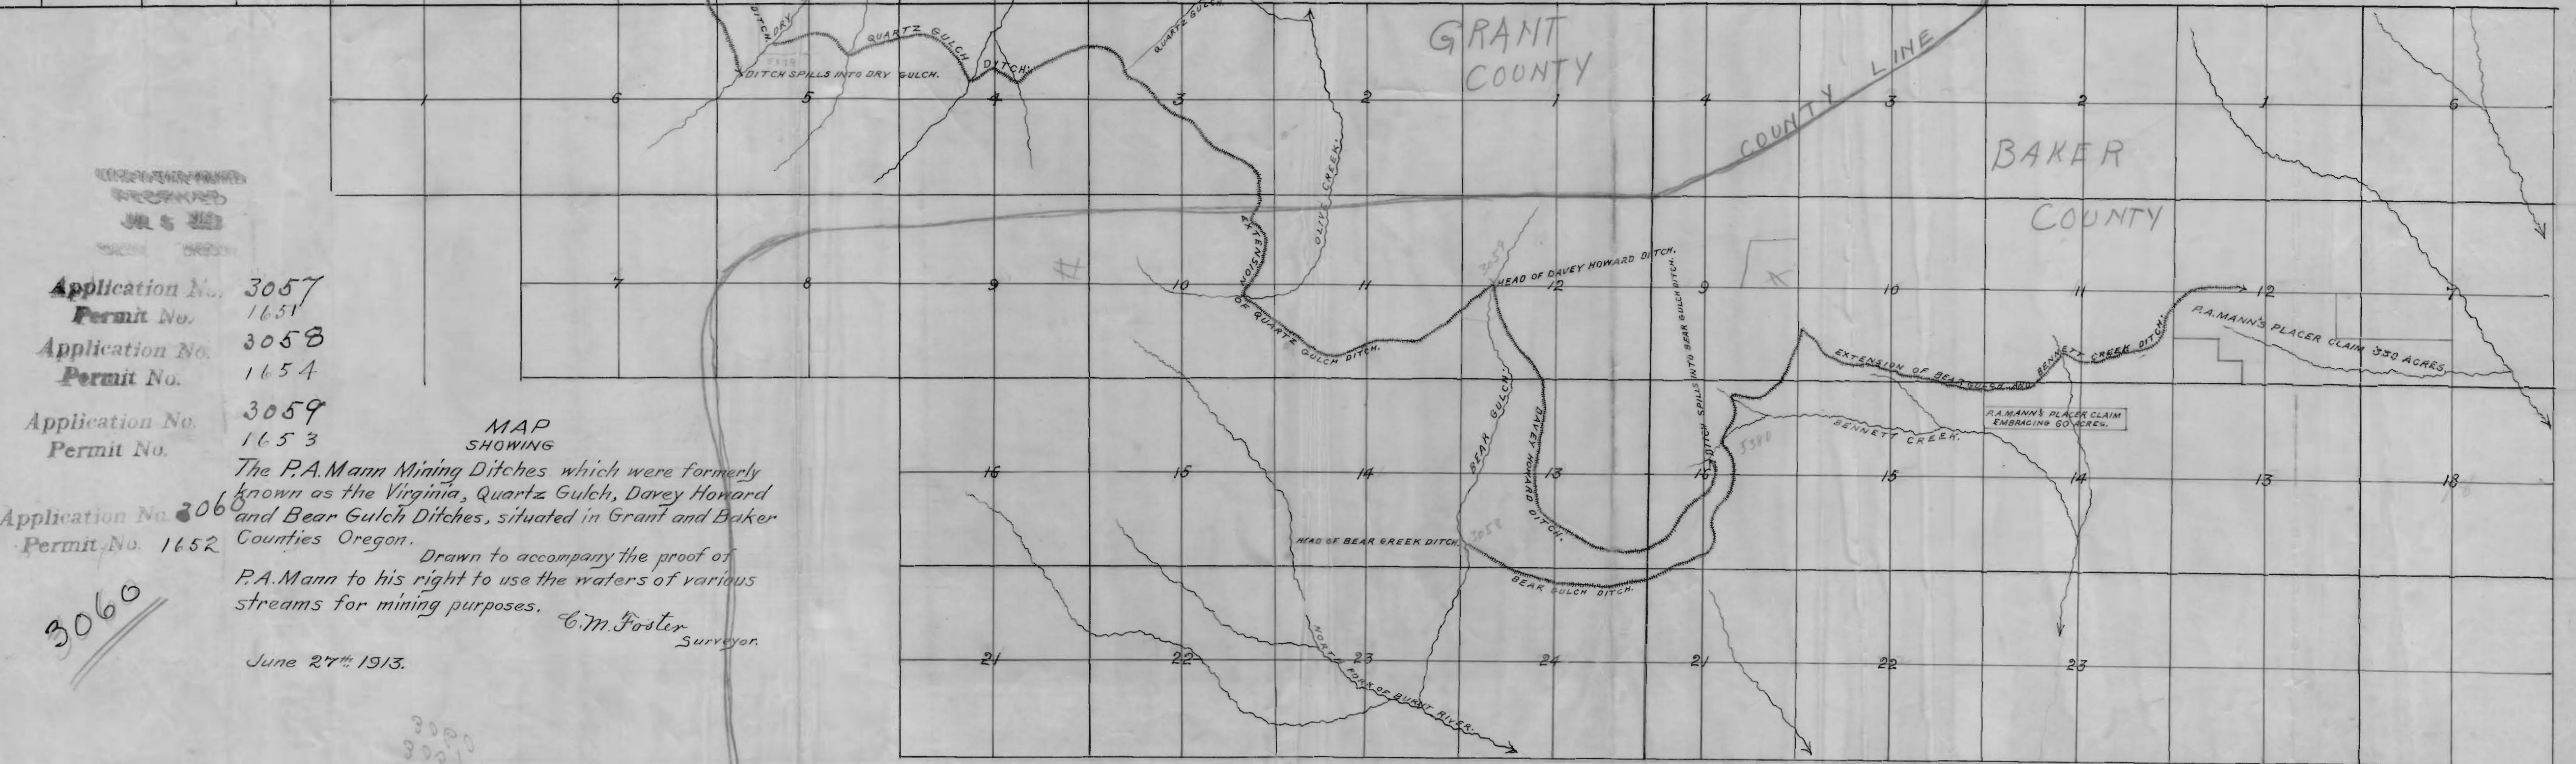

- Application No. 3057
Permit No. 1651
- Application No. 3058
Permit No. 1654
- Application No. 3059
Permit No. 1653

Application No. 3060
Permit No. 1652

MAP SHOWING

The P.A. Mann Mining Ditches which were formerly known as the Virginia, Quartz Gulch, Davey Howard and Bear Gulch Ditches, situated in Grant and Baker Counties Oregon.

Drawn to accompany the proof of P.A. Mann to his right to use the waters of various streams for mining purposes.

C.M. Foster
Surveyor.

June 27th 1913.

3060

3057
3058
3059
3060