


SECTION

10

TOWNSHIP 34S, RANGE 1W, W. M.

North

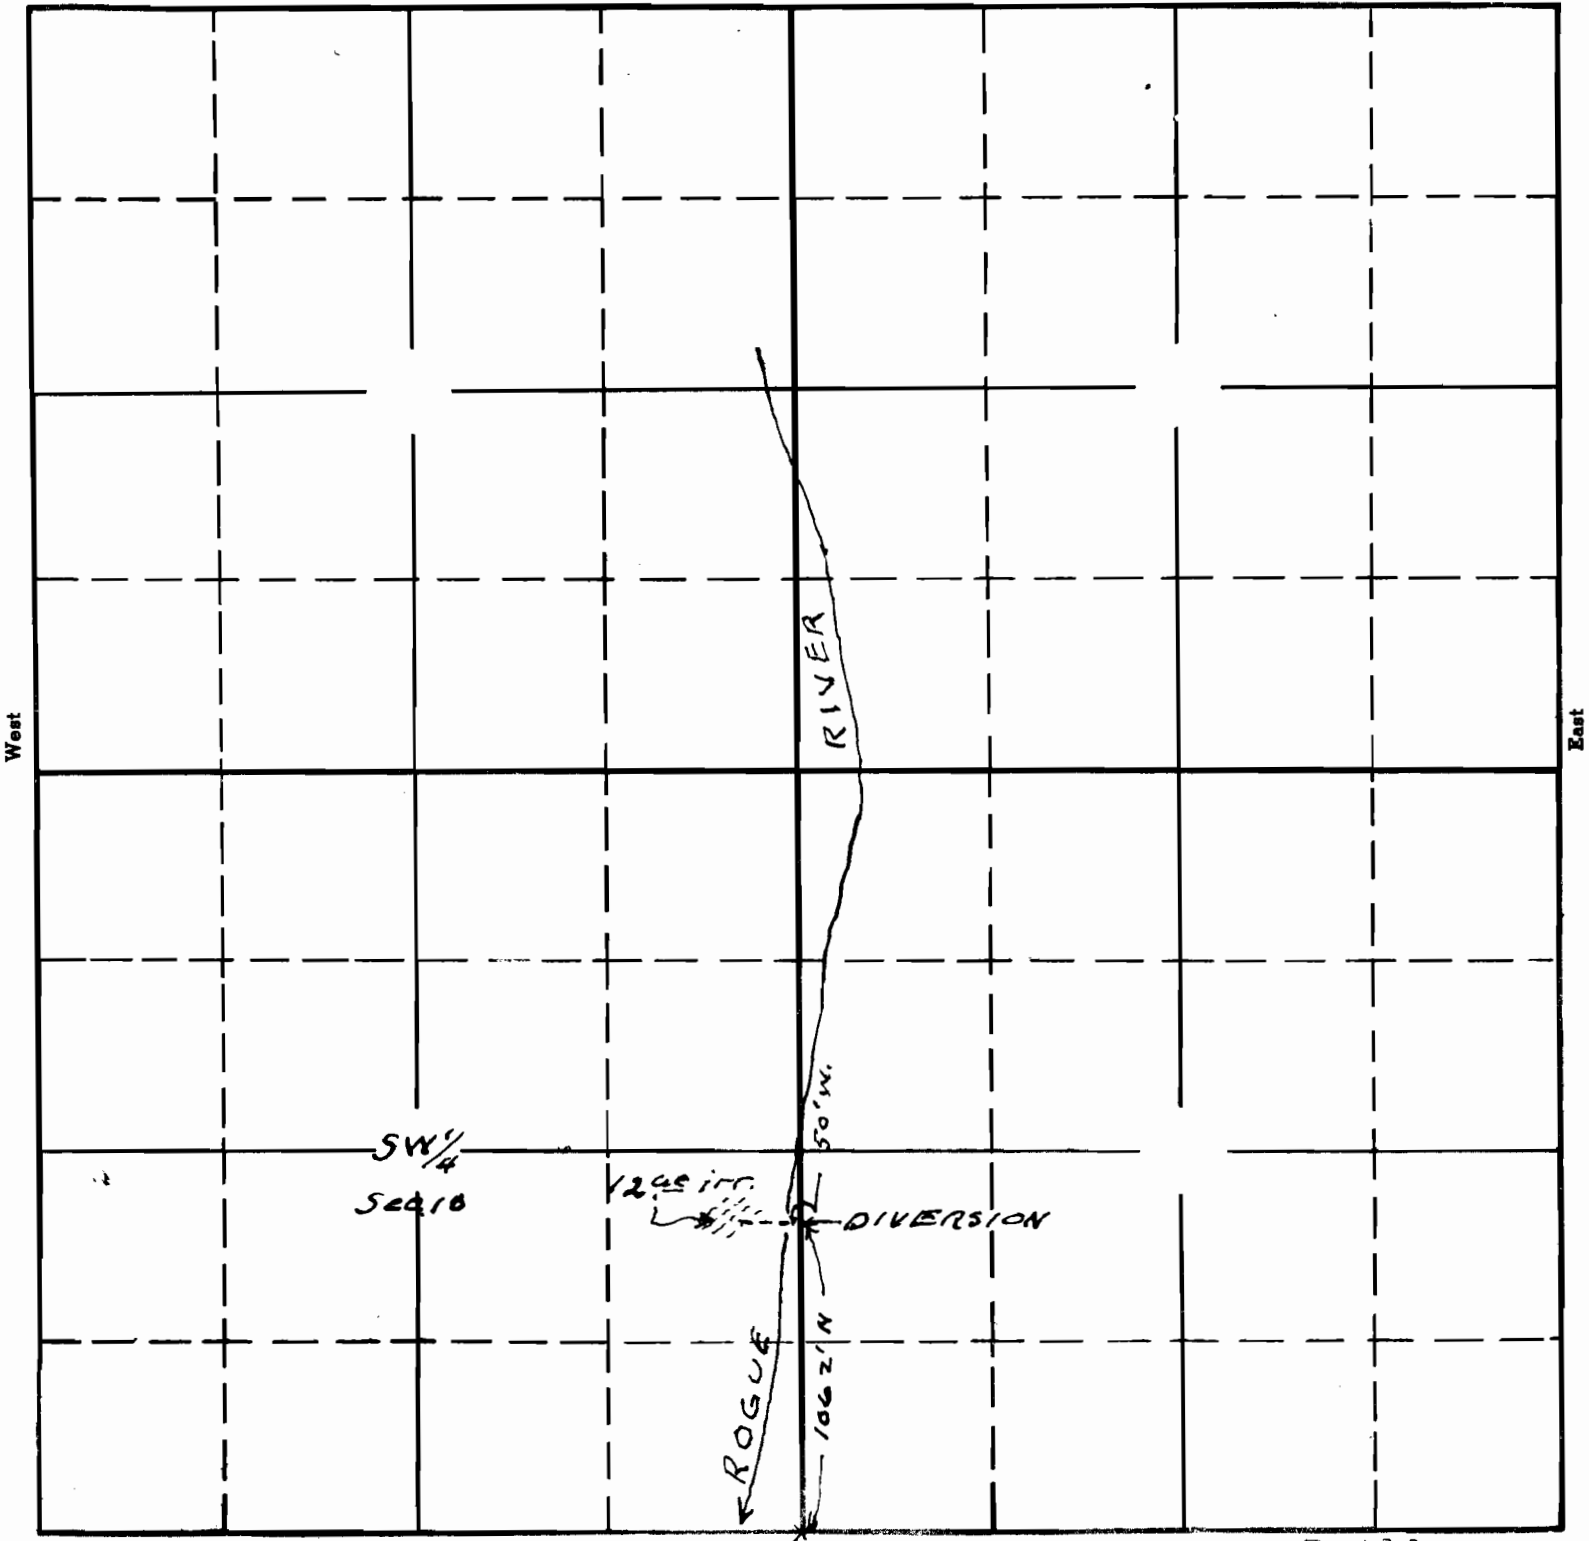

South

Map To accompany application of  
 Thomas R Hall for use of Rogue River  
 waters for irrigation purposes

21133  
 15-60A  
 APPLICATION No. 21133  
 PERMIT No. 16562

This office 5/30/15 *[Signature]*