


Permit: S 16575
Volume: 5
Strm: UNN CR/RES
Trib: JUMPOFF JOE CR
Priority: 9/07/45
21-6-28

Tp. 34 S.
R. 6 W.
W.M.

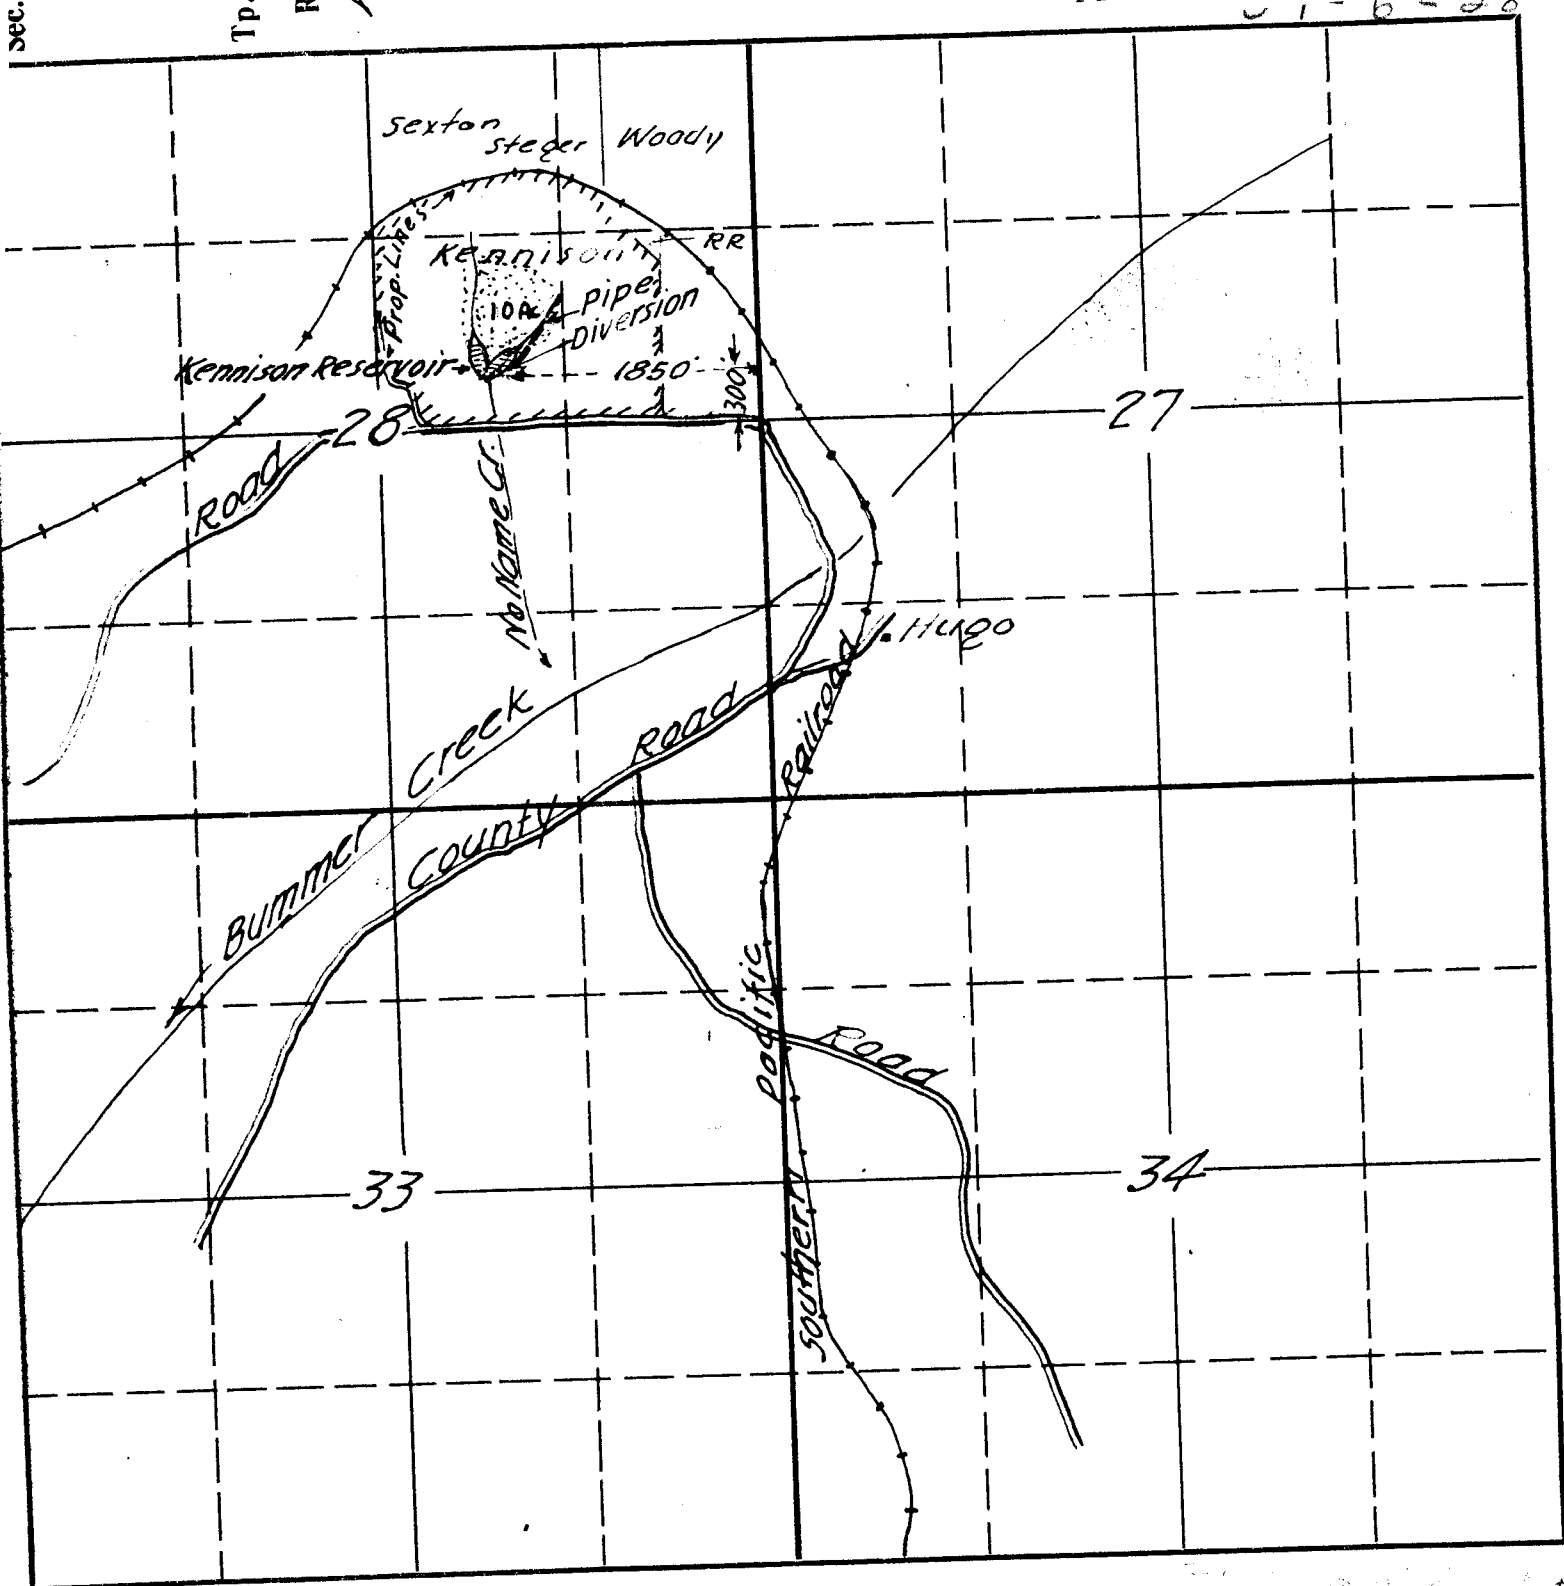

R.S. Kennison
Sept. 1945

Application No. 21150
Permit No. R-826