T. 34 S., R 8 W., W. M.

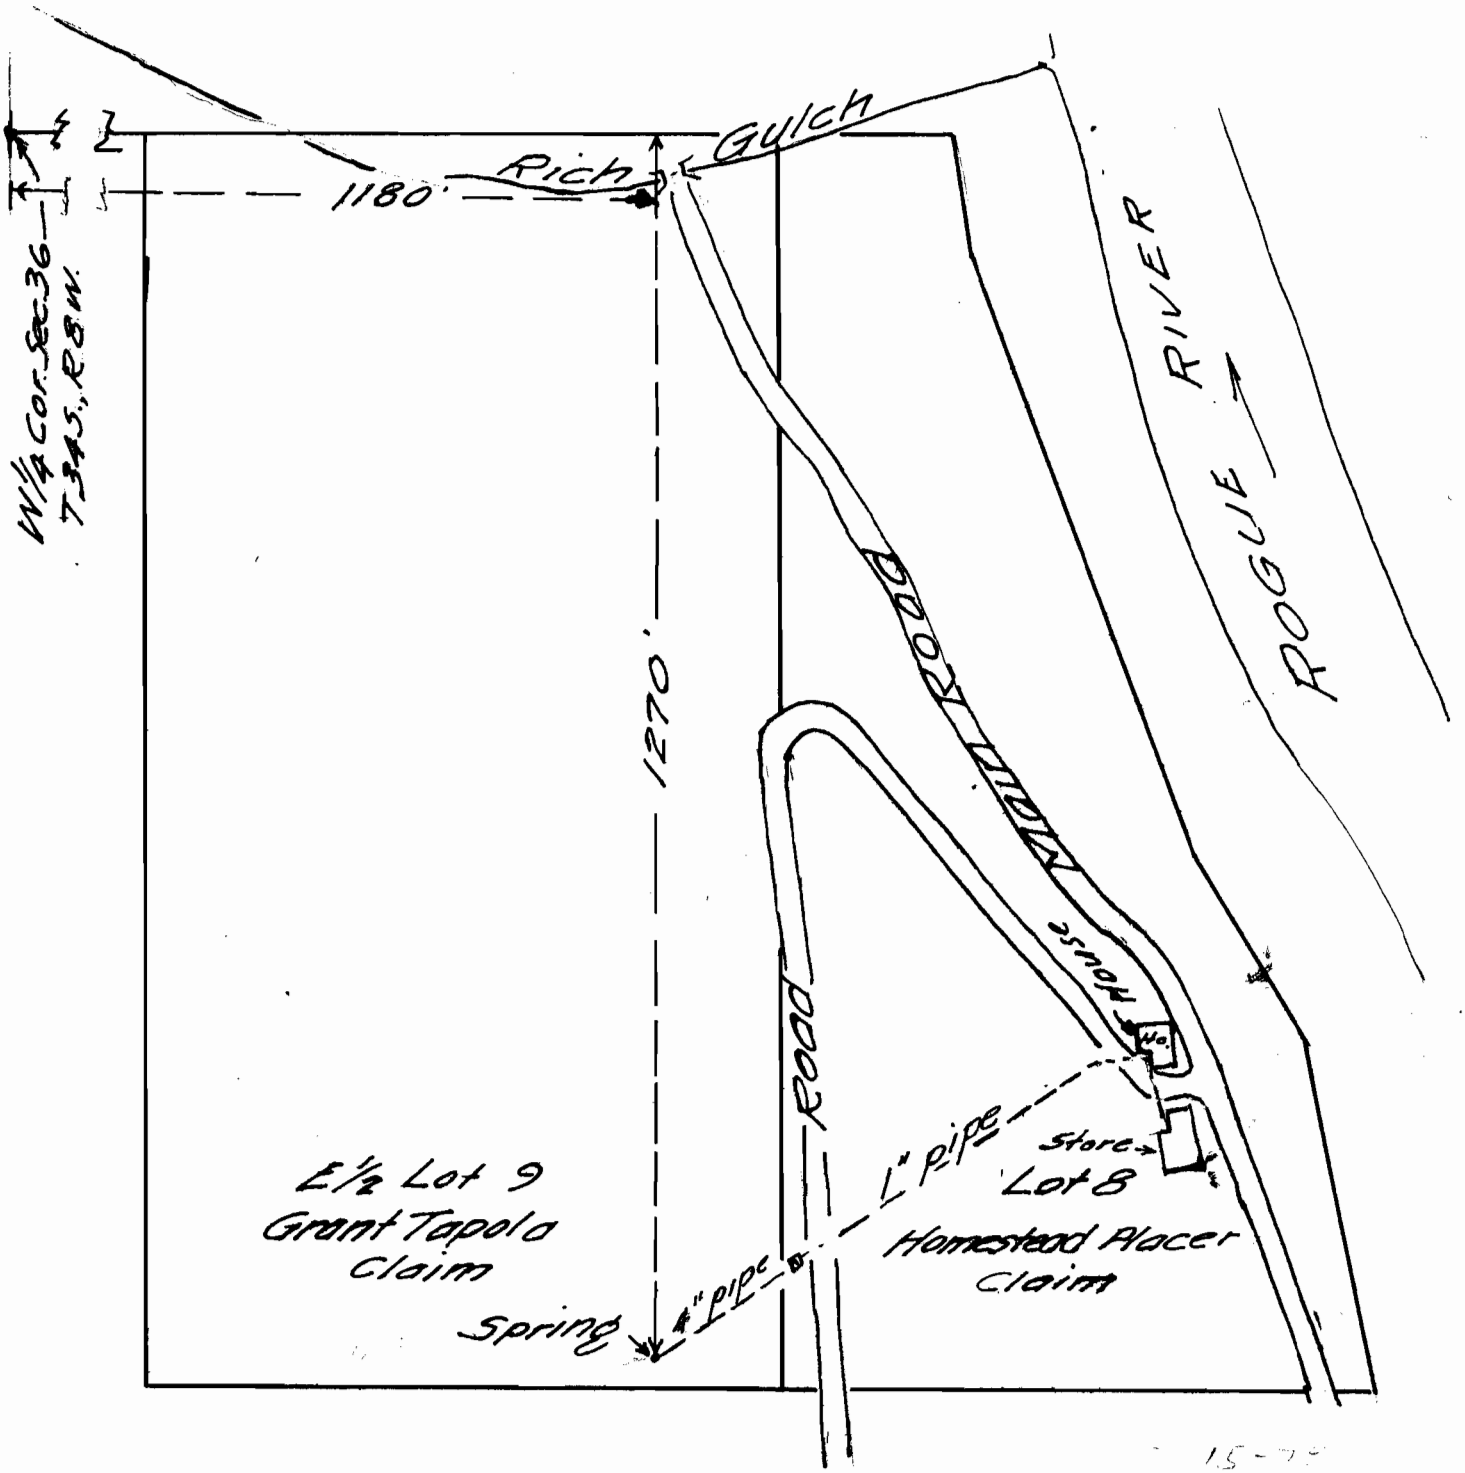

Harry Sordy
Sept. 1945

Application No. 21171
Permit No. 16590

RECEIVED
SEP 1945
STATE ENGINEER
SALEM, OREGON