


SECTION

\_\_\_\_\_  
\_\_\_\_\_  
//  
\_\_\_\_\_  
\_\_\_\_\_

TOWNSHIP 39 S, RANGE 1 W, W. M.

North

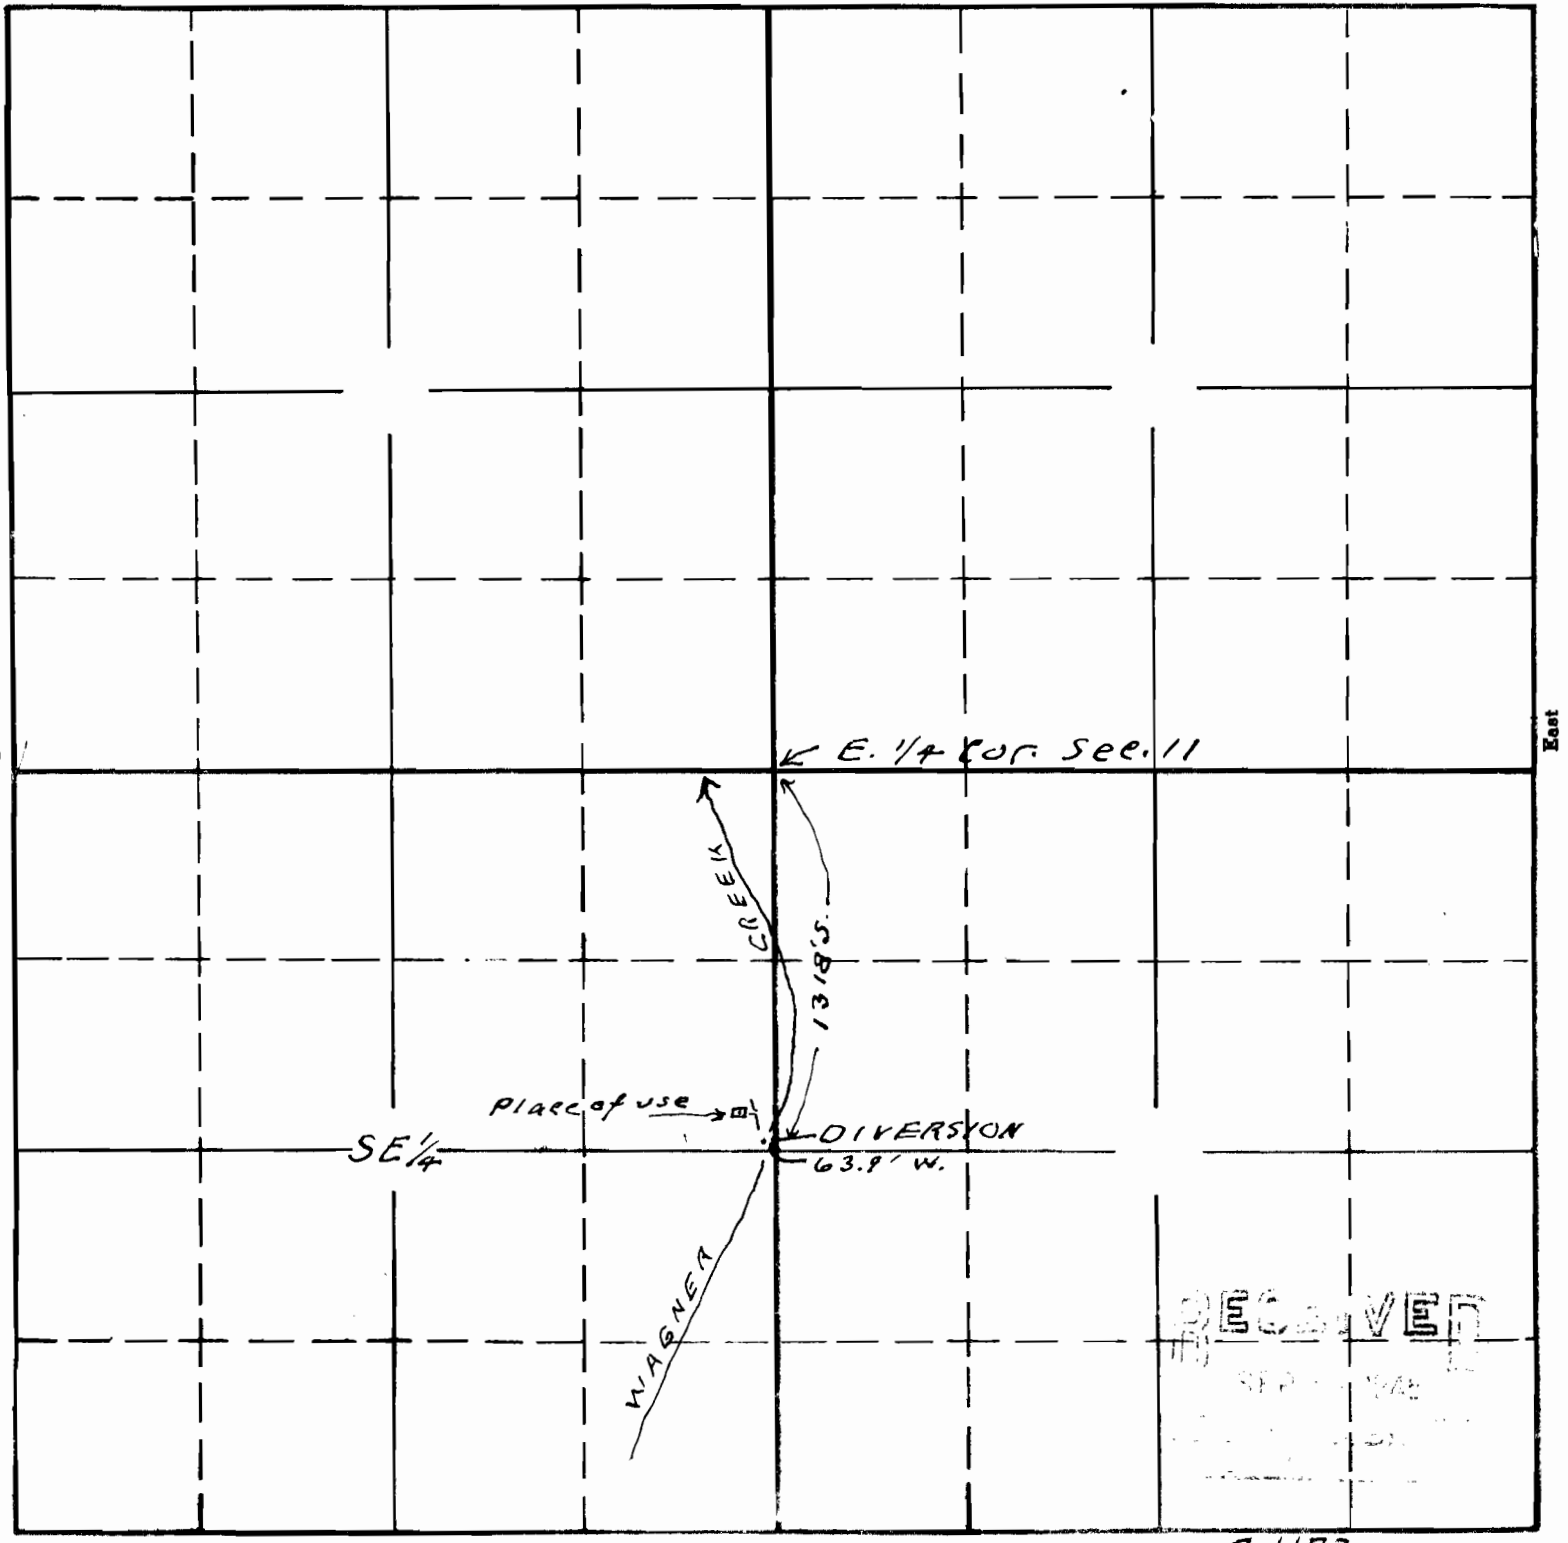

South

RECEIVED  
SEP 14 1945

Map to accompany application of Elmer F Hays for use of waters of Wagner Creek for domestic and garden purposes

21172  
APPLICATION No. 21172  
PERMIT No. 16591

This office 9/15/45 *White*