


Sec.

Tp. 37 S.

R. 5 W.

N. 7

RECEIVED

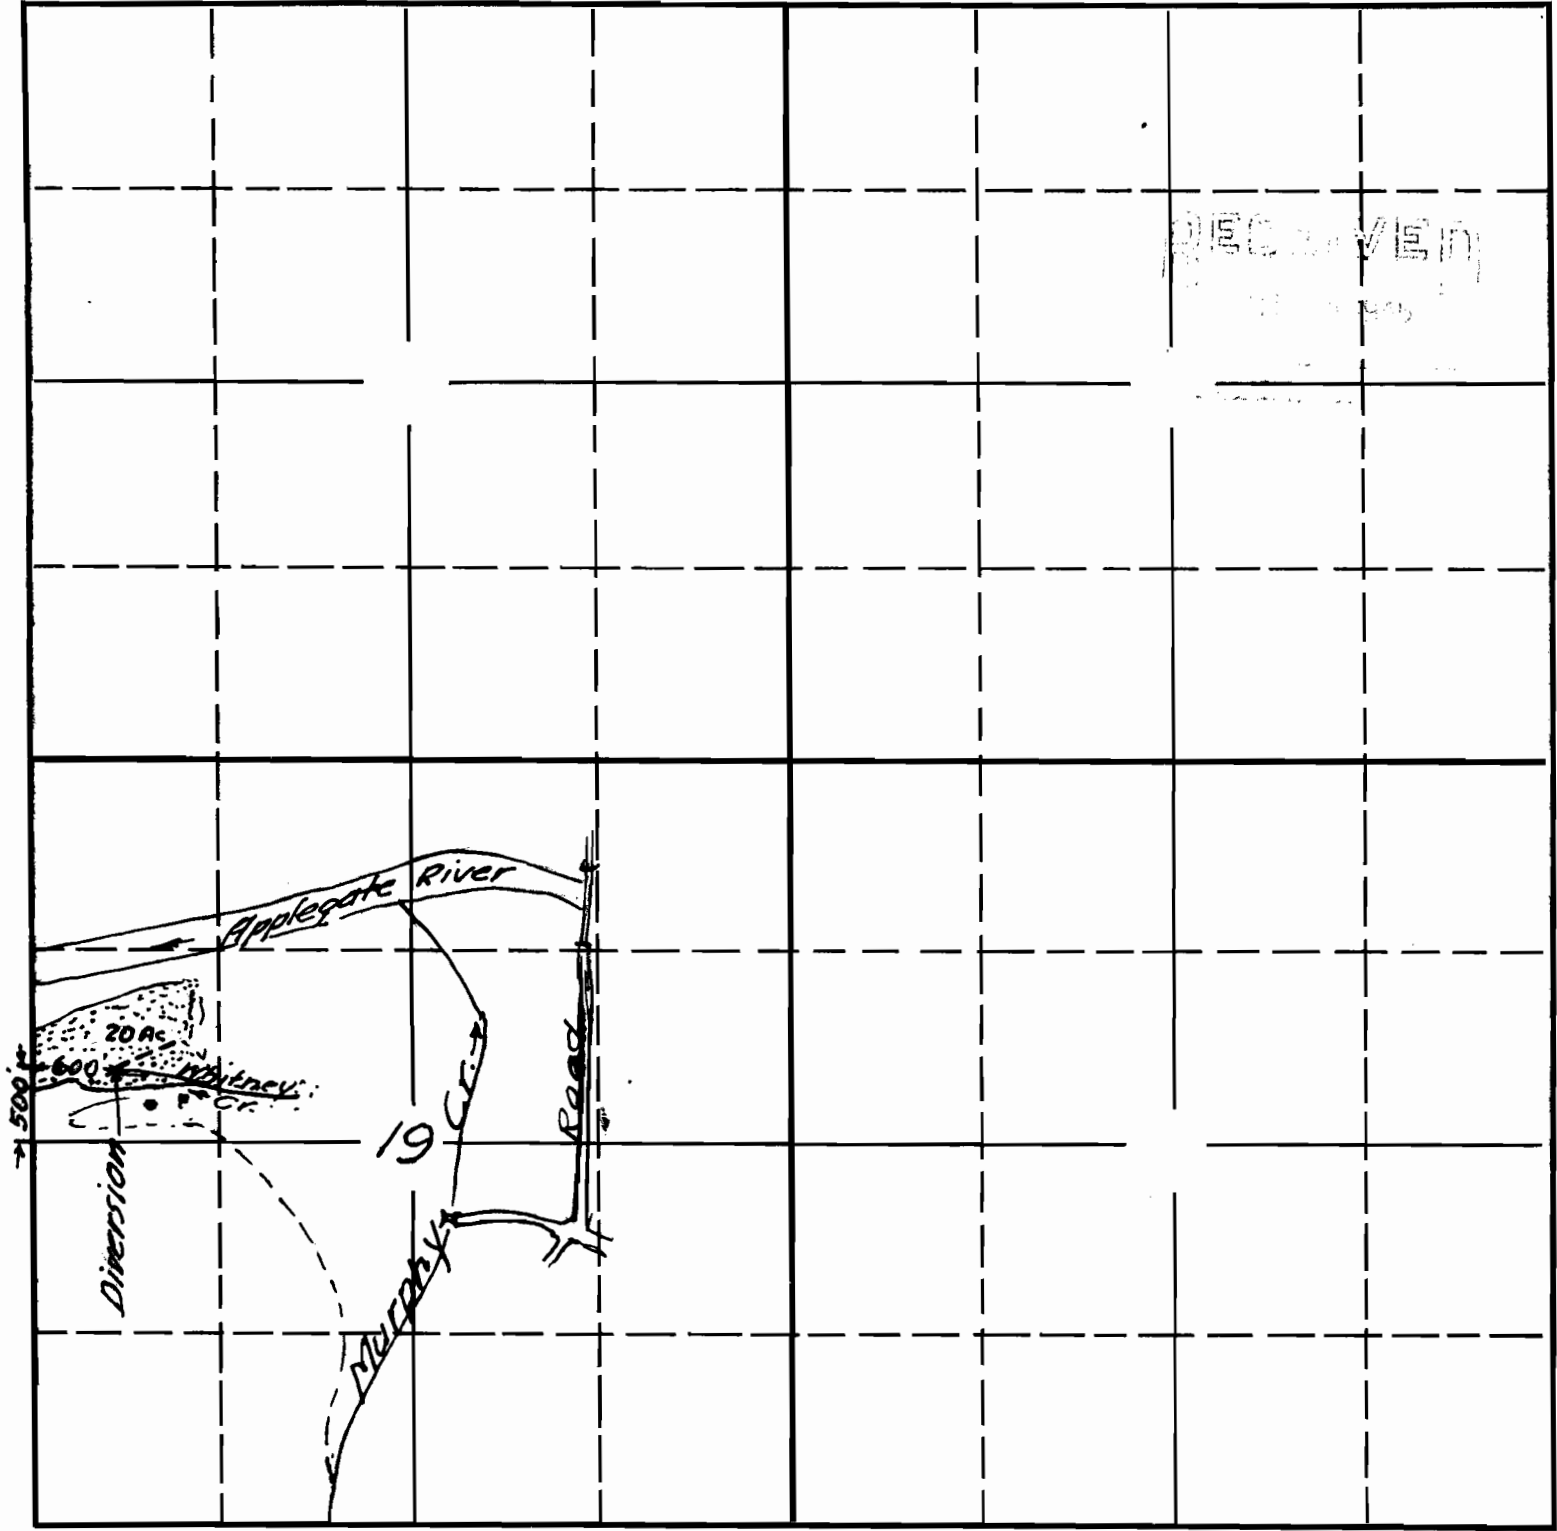

Violet W. Whitney
56 Oct. 1945

Application No. 21205
Permit No. 16622

21205
15-160