


SECTION

TOWNSHIP ²⁵15, RANGE ^{2E}2E, W. M.

North

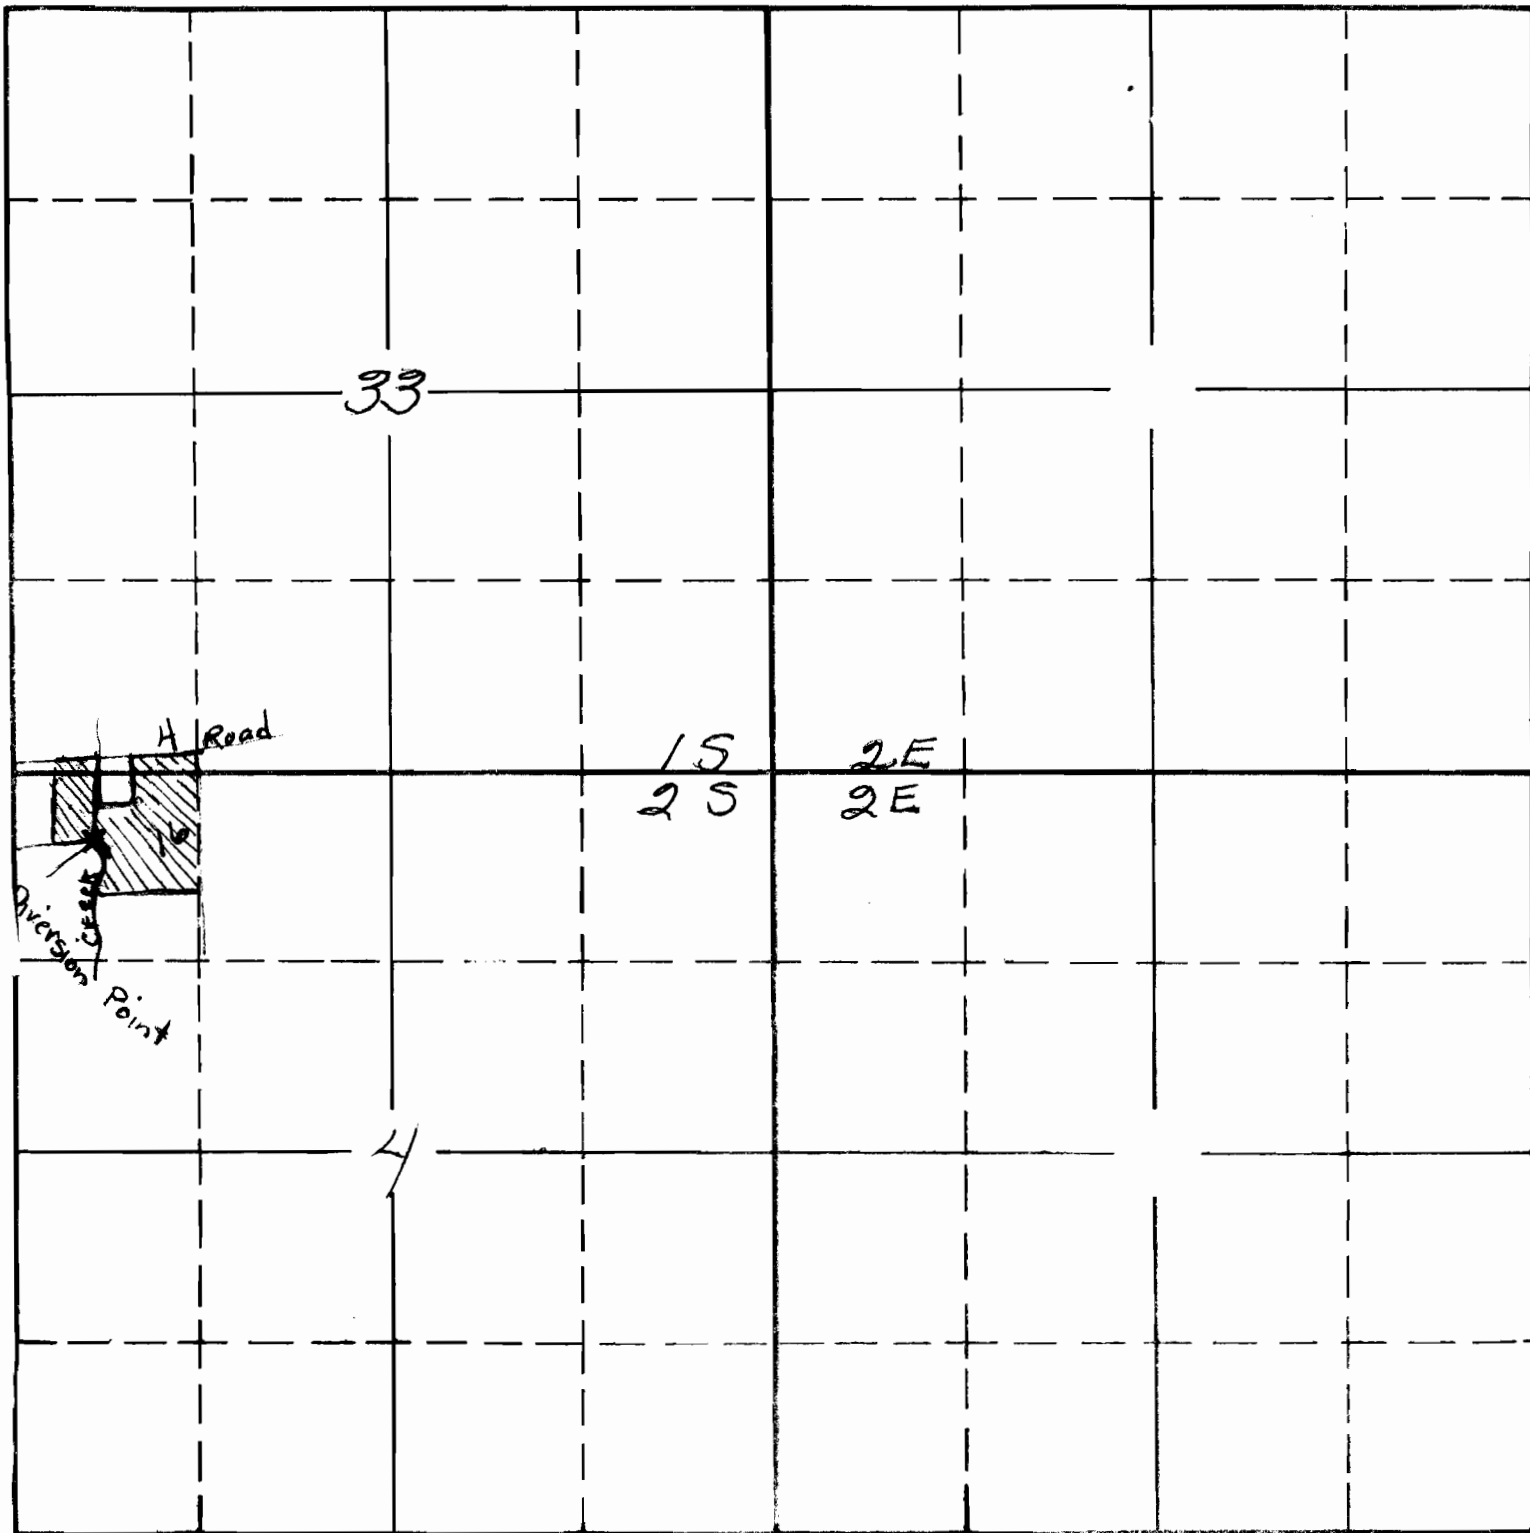

East

South

21232

-763

APPLICATION No. 21232

PERMIT No. 16641