


SECTION

TOWNSHIP _____, RANGE _____, W. M.

North

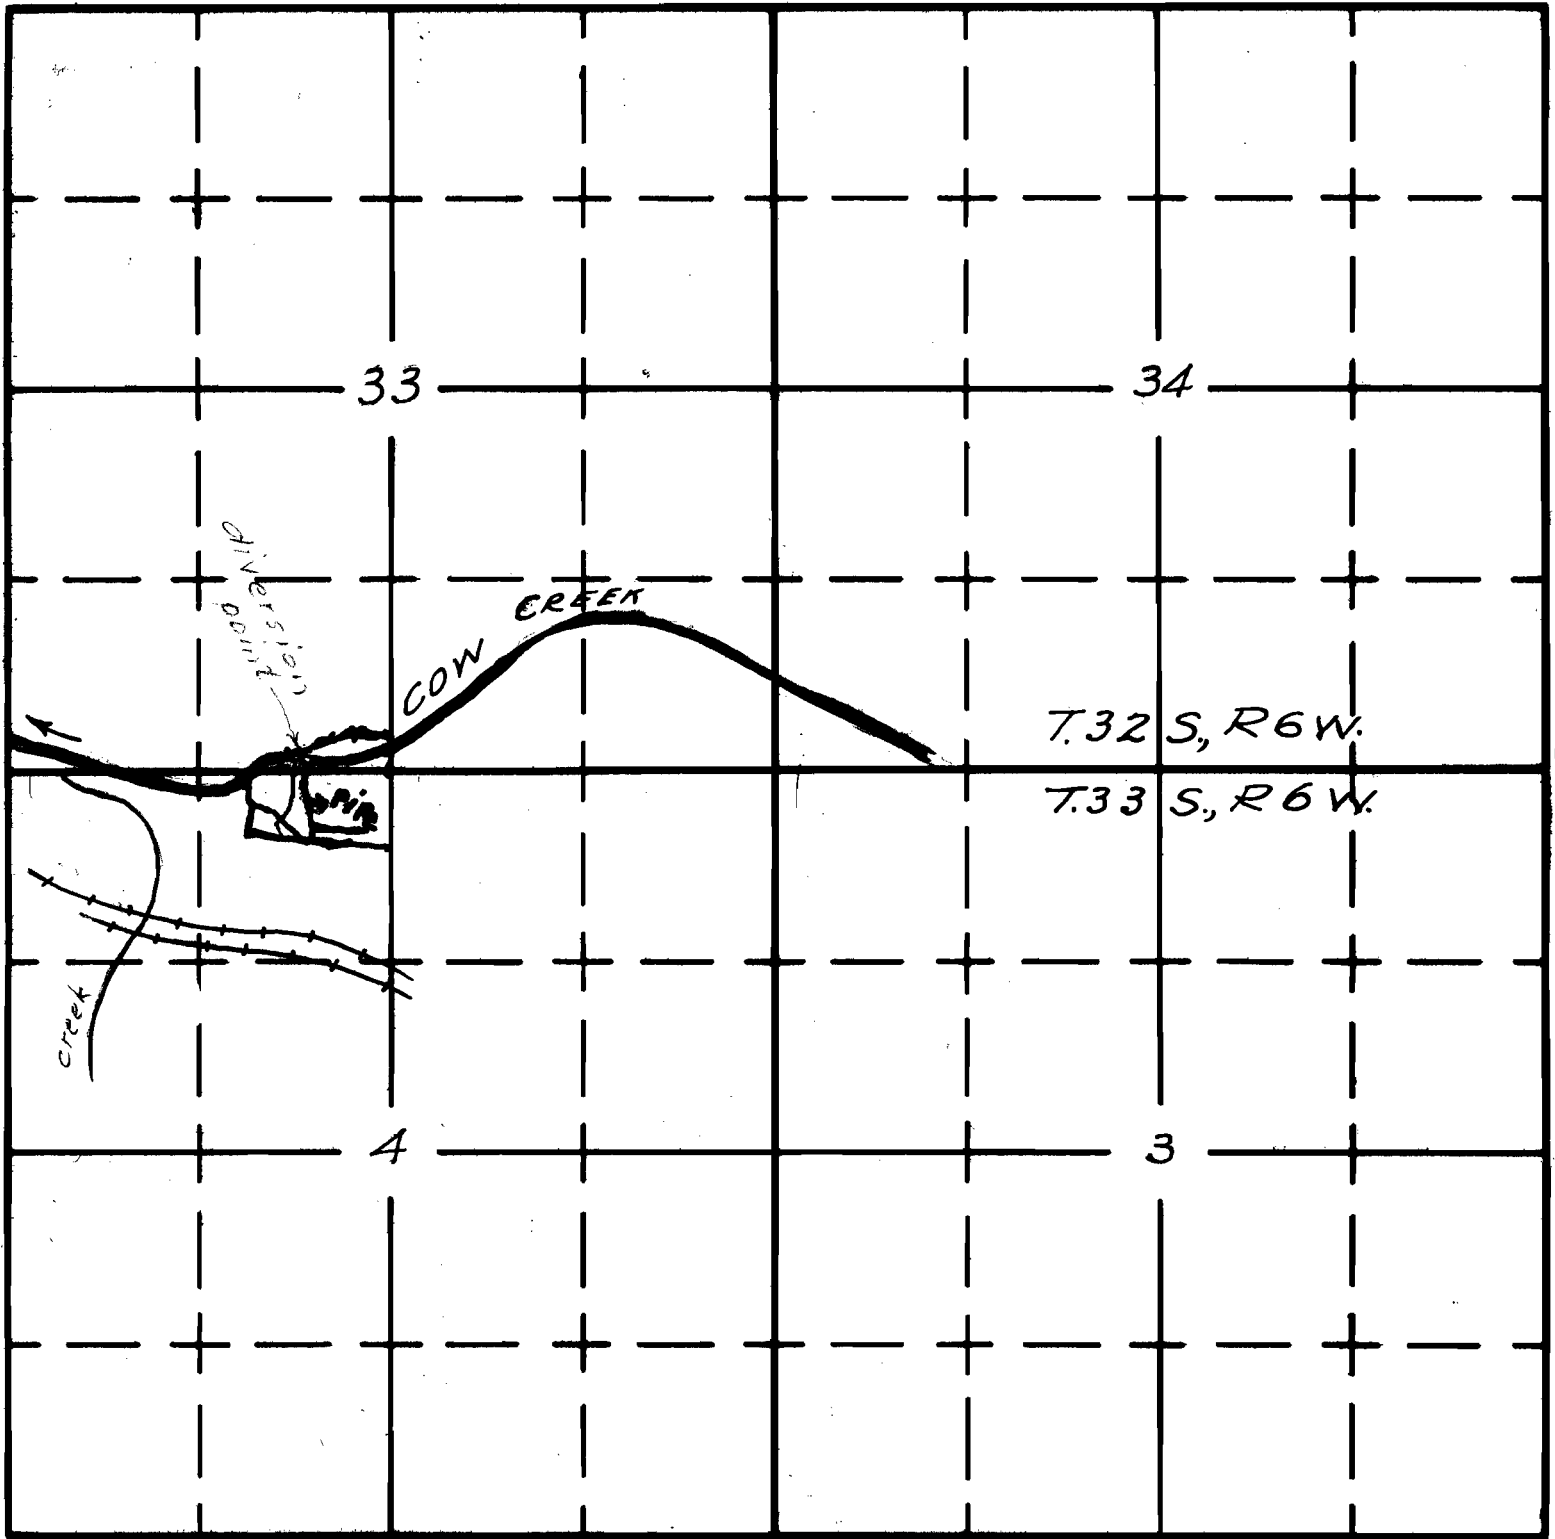

South

RECEIVED

NOV 13 1945

STATE ENGINEER
SALEM, OREGON

APPLICATION No. 21255
PERMIT No. 16657