


16699 P.16699

1963

T. 38 S. R. 3 W. W. M.

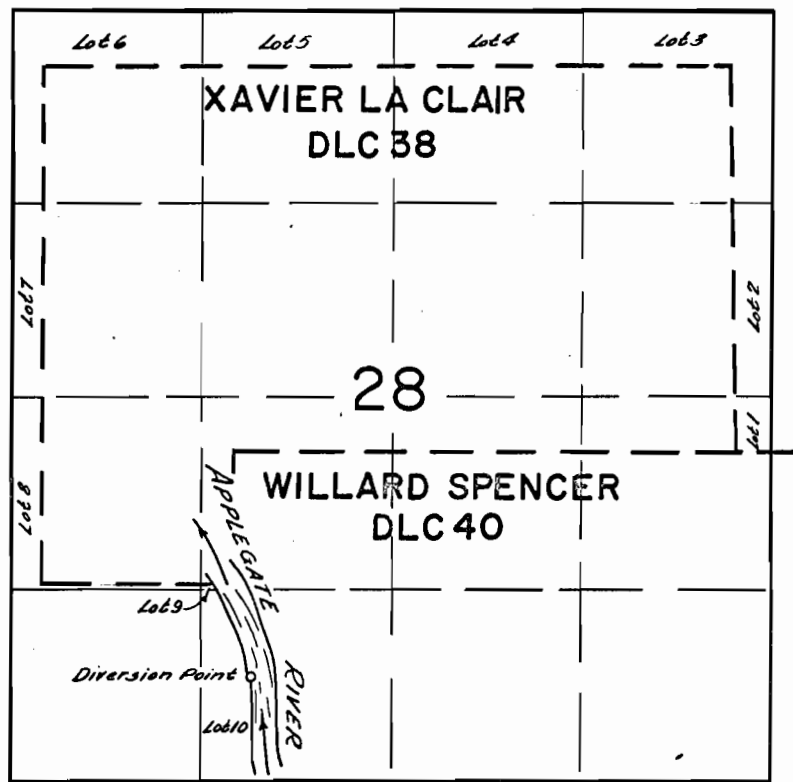

FINAL PROOF SURVEY
UNDER

Application No. D-97..... Permit No.
IN NAME OF

.....**Marion Dunlap**.....

Surveyed July..17.. 1963., by .C.Baker.....