


Permit: S 16823  
Volume: SA  
Strm: A SPE  
Trib: DWIGHT CR  
Priority: 2/28/46

T41S, R9W.  
Scale 400' = 1"

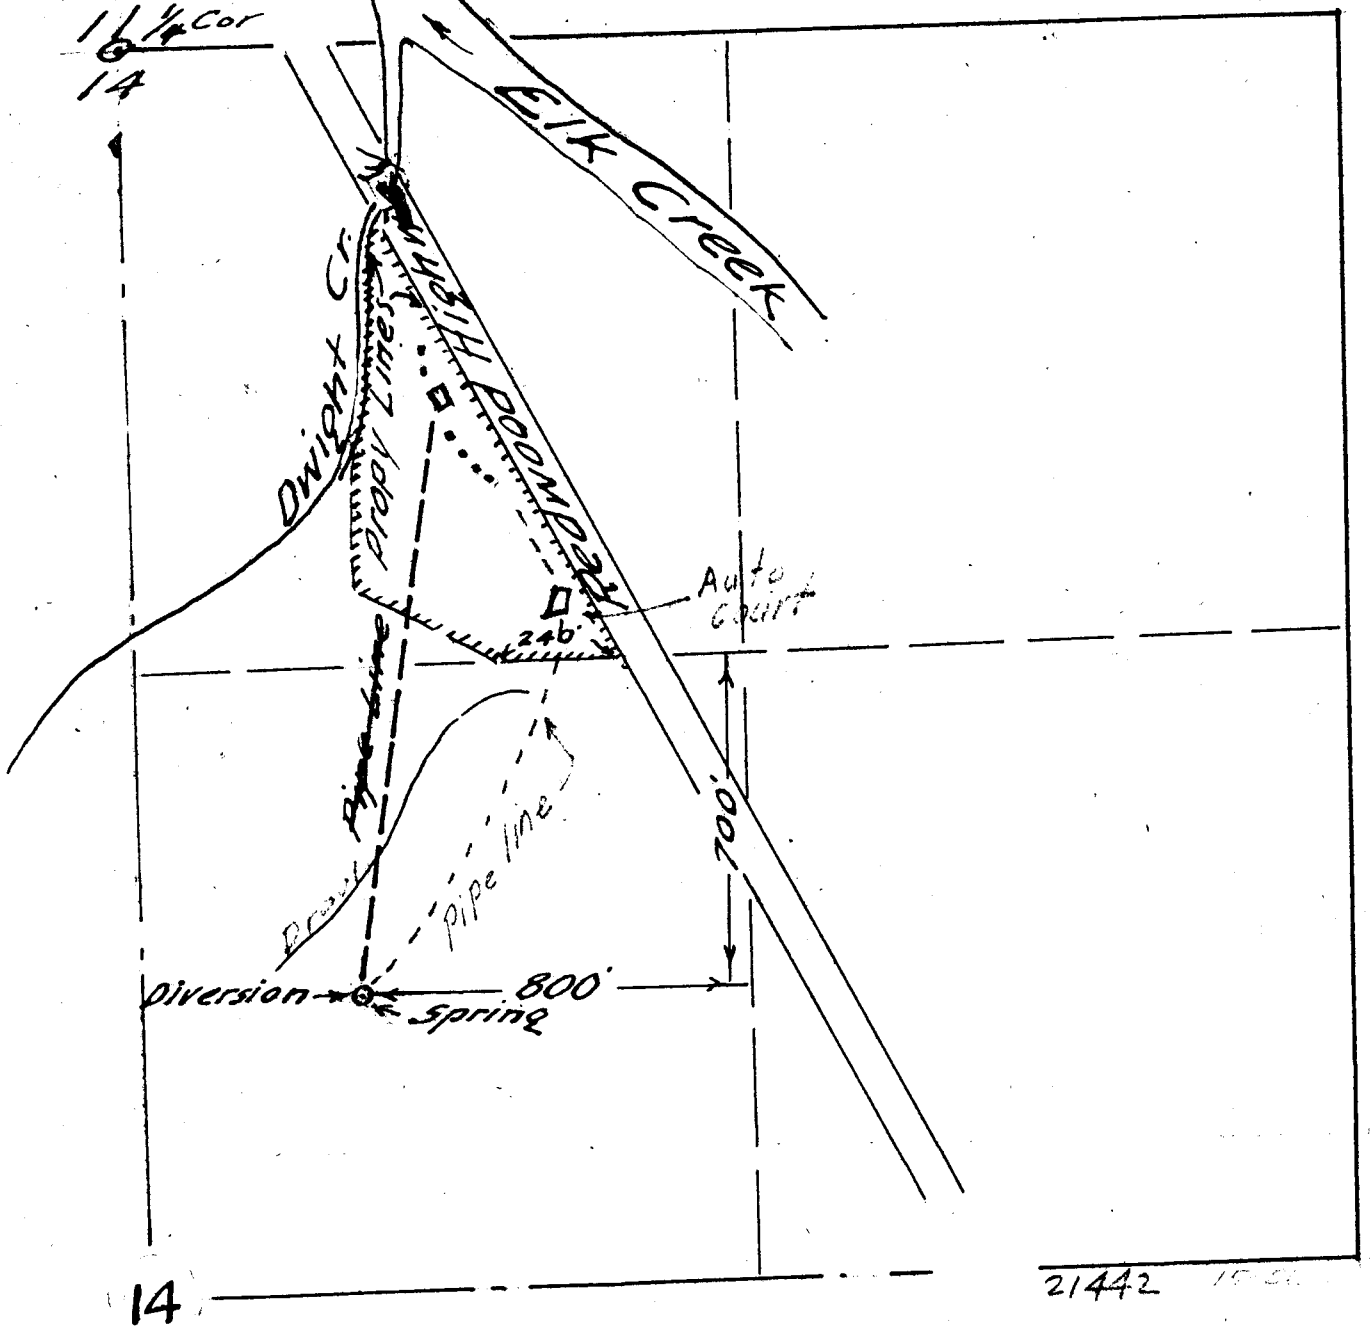

Stella K. Johnson  
Feb. 1946

Application No 21442  
Permit No. 16823