


SECTION

Permit: S 16871
Volume: 4A
Strm: TAYLOR CR
Trib: ROGUE R
Priority: 3/28/46

TOWNSHIP 35 S, RANGE 8 W

North

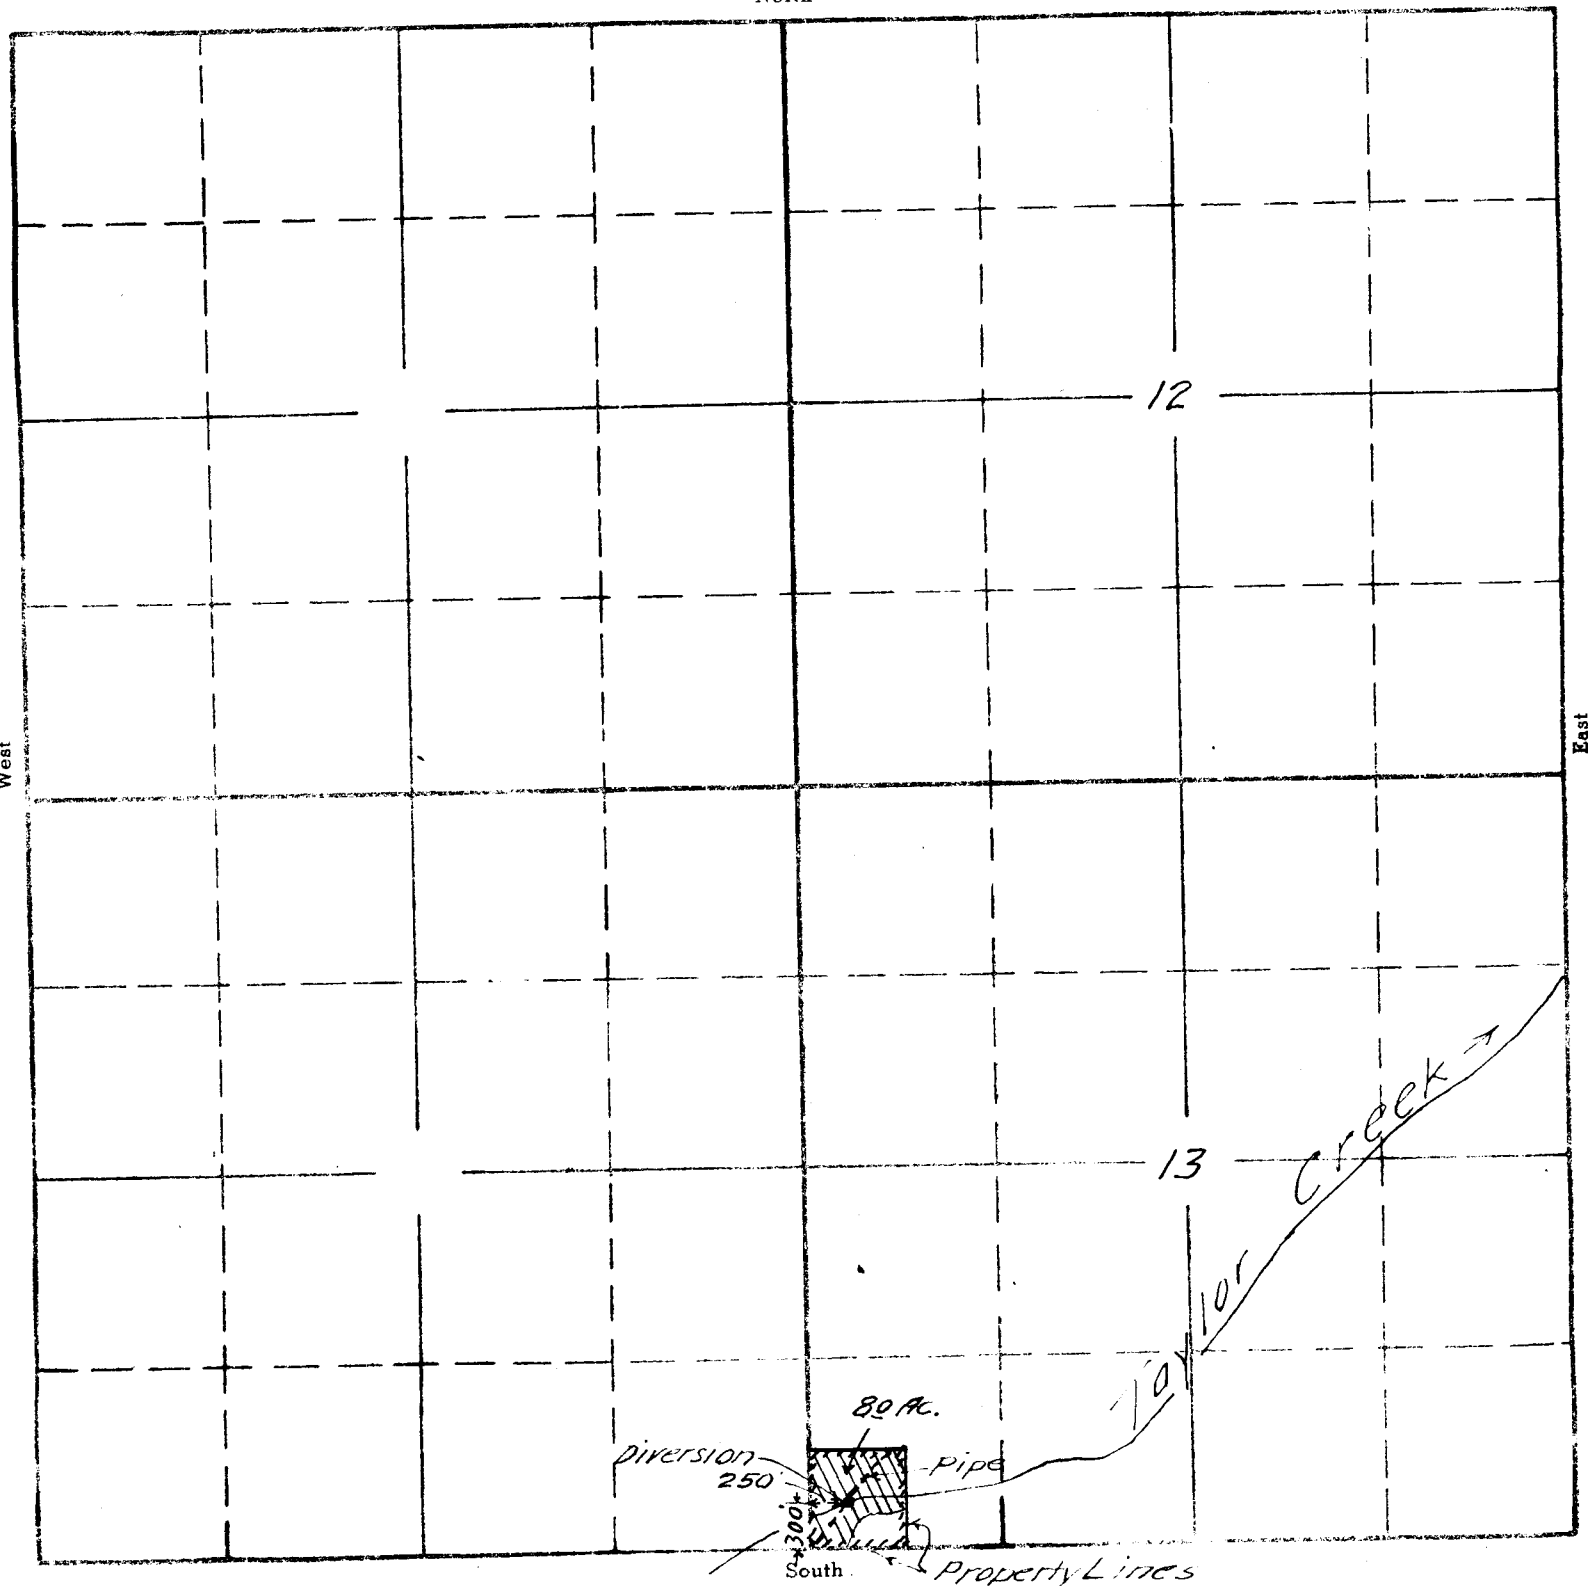

Paul S. English
Mar. 1946

APPLICATION No. 21514
PERMIT No. 16871