


SECTION

TOWNSHIP 5 S, RANGE 8 W, W. M.

North

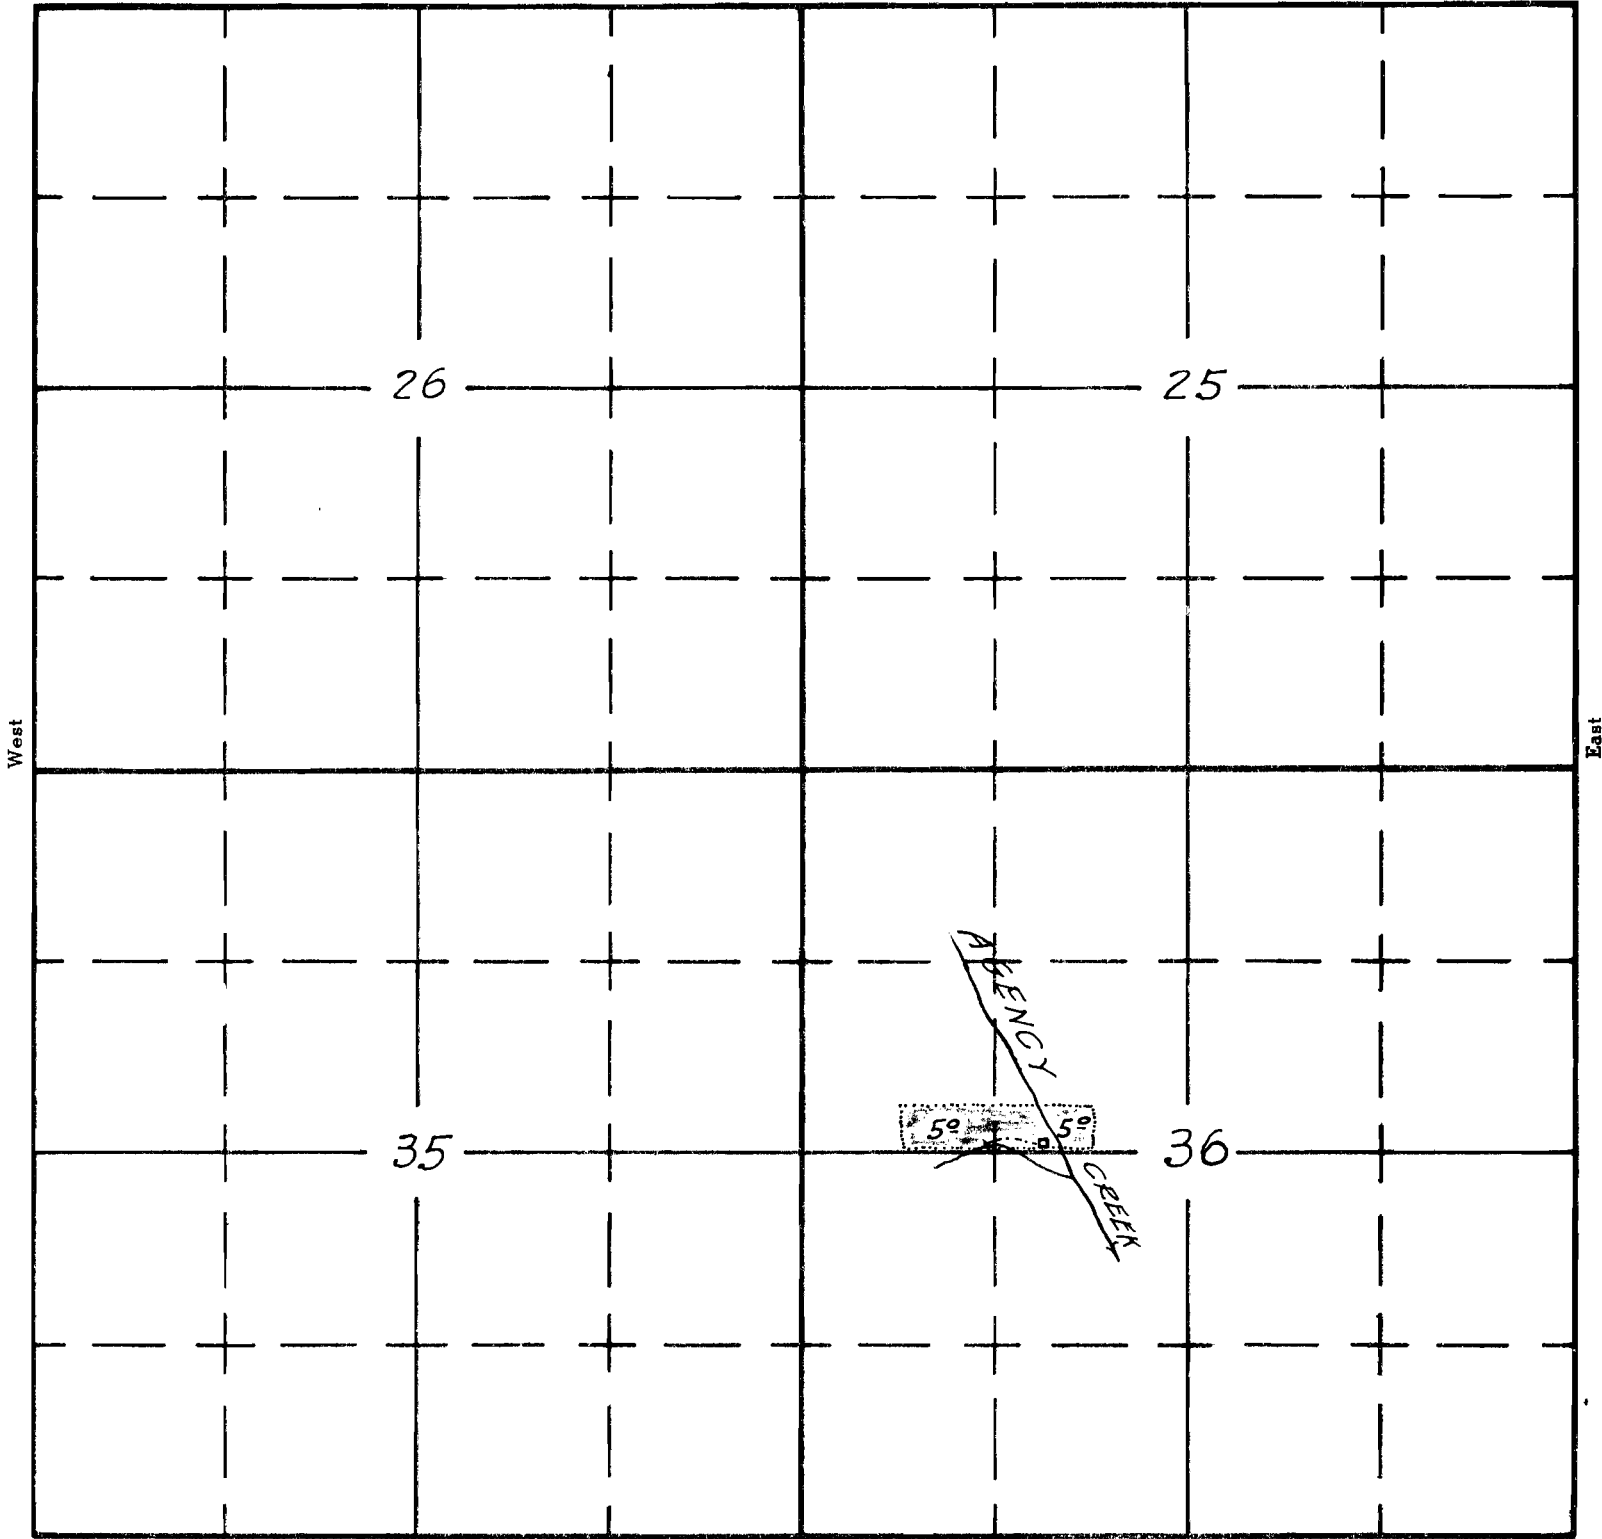

South

**SKETCHED IN THE OFFICE
OF THE STATE ENGINEER
FROM DATA BY APPLICANT**

A-10-46

EKN

APPLICATION No. 21040

PERMIT No. 10000