


SECTION

TOWNSHIP 34 S., RANGE 6 W., W. M.

North

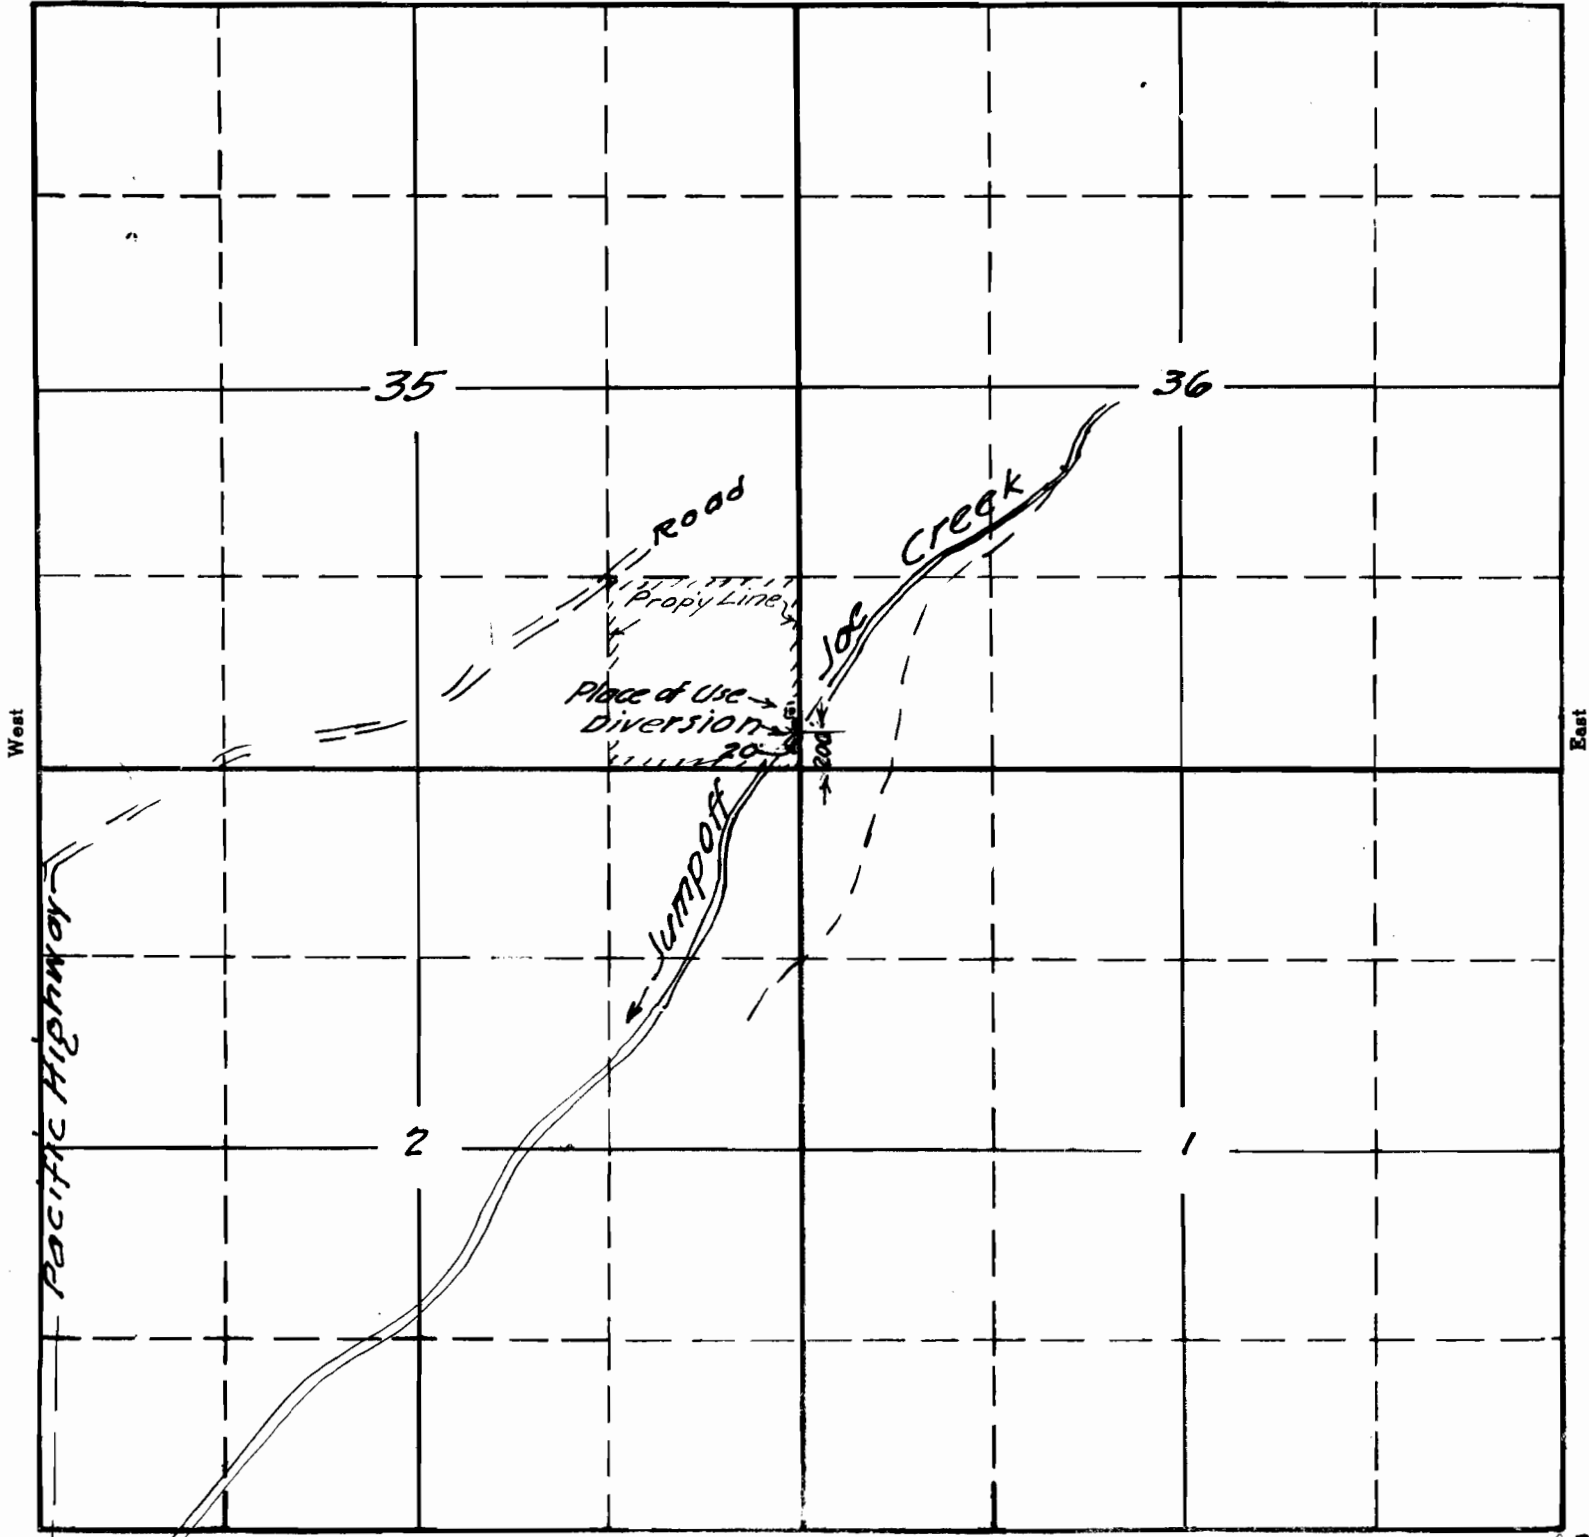

South

21598

15-78D

RECEIVED

APR 1946

STATE ENGINEER

Dewey Bjorge
April 1946

APPLICATION No. **21598**

PERMIT No. **16970**