


SECTION

TOWNSHIP 39 S, RANGE 8 N, W. M.

North

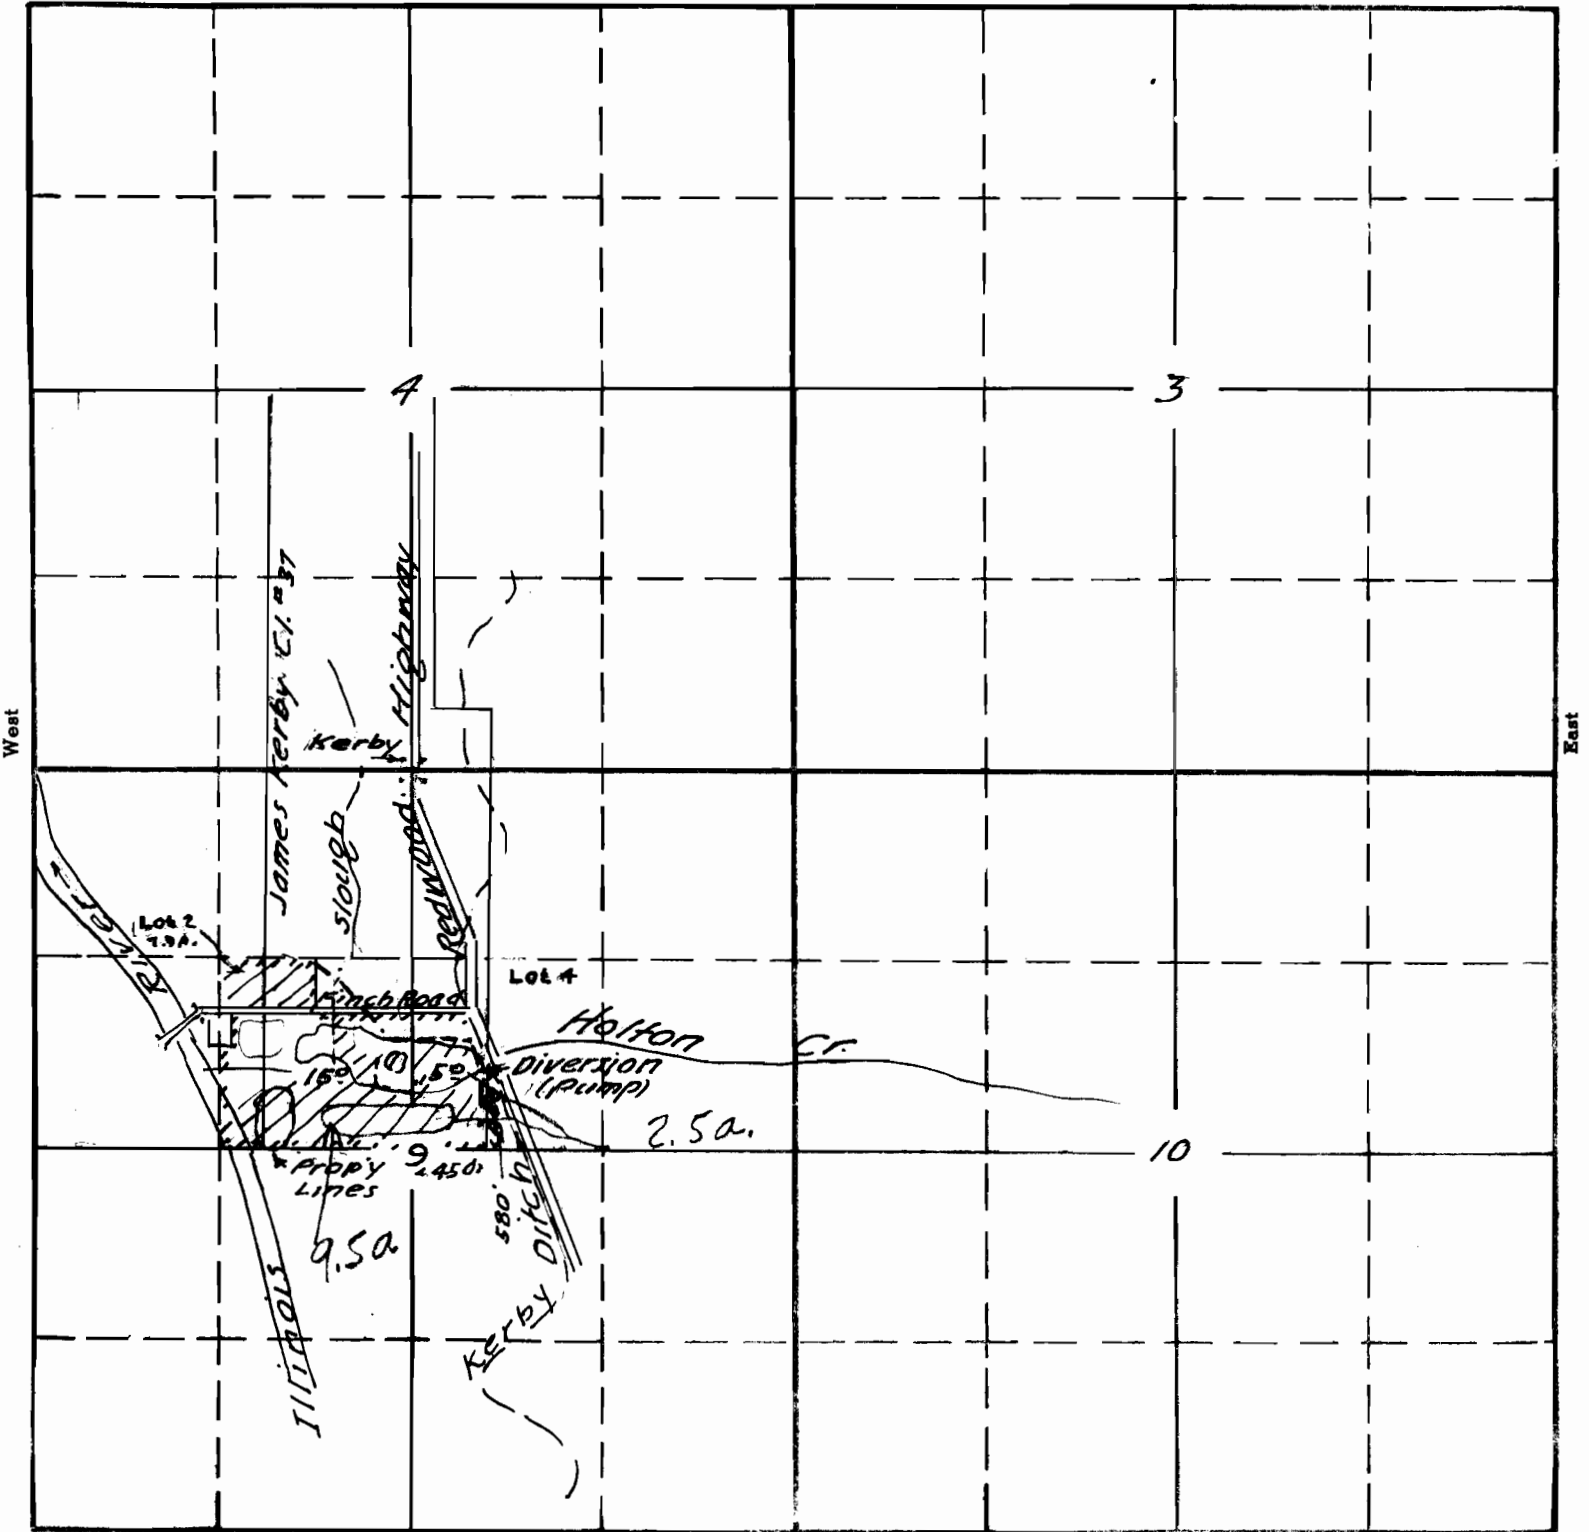

West

East

South

21632

15-560

Alvin F. Lockett
May 1946

RECEIVED

APPLICATION No. 21632
PERMIT No. 16998

WATER RIGHT

ENGINEER

STATE OF OREGON