


T.41S.R.13W.W.M.

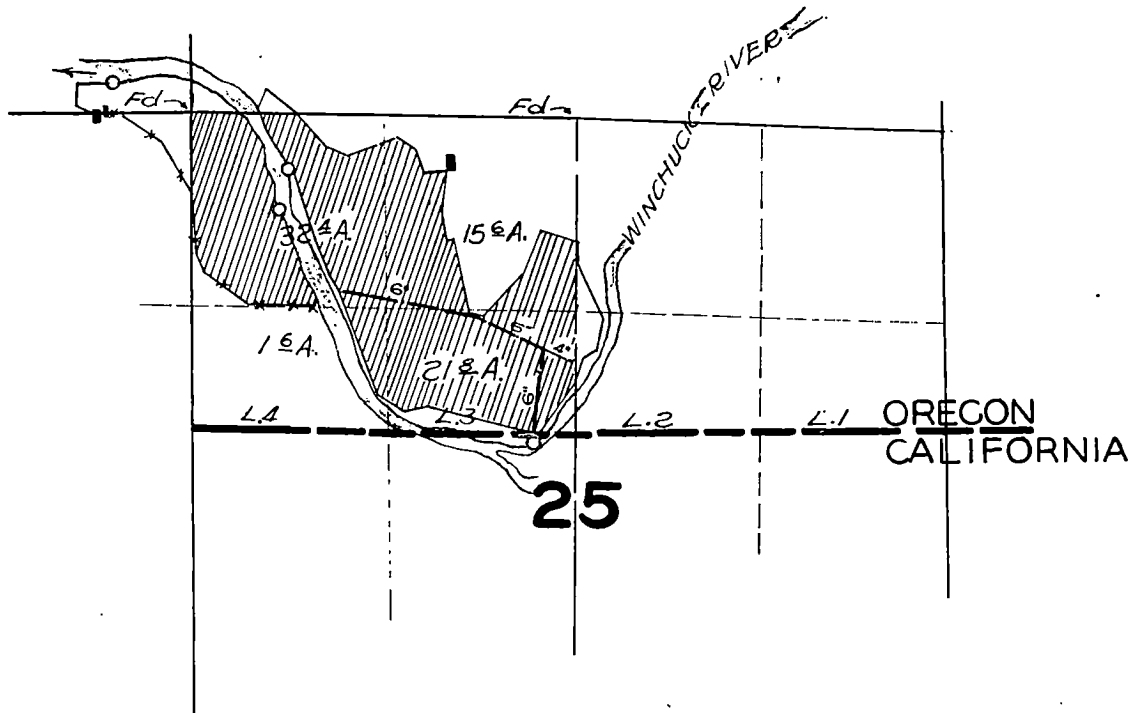

○ = DIVIRSION POINT
■ = BUILDINGS

FINAL PROOF SURVEY

UNDER

Application No. 21640... Permit No. 17001...
IN NAME OF

.....M.L. DEMARTIN.....

Surveyed AUG. 9. 1949., by H.L. COFFMAN.