


SECTION

TOWNSHIP 37 S, RANGE 6 W, W. M.

North

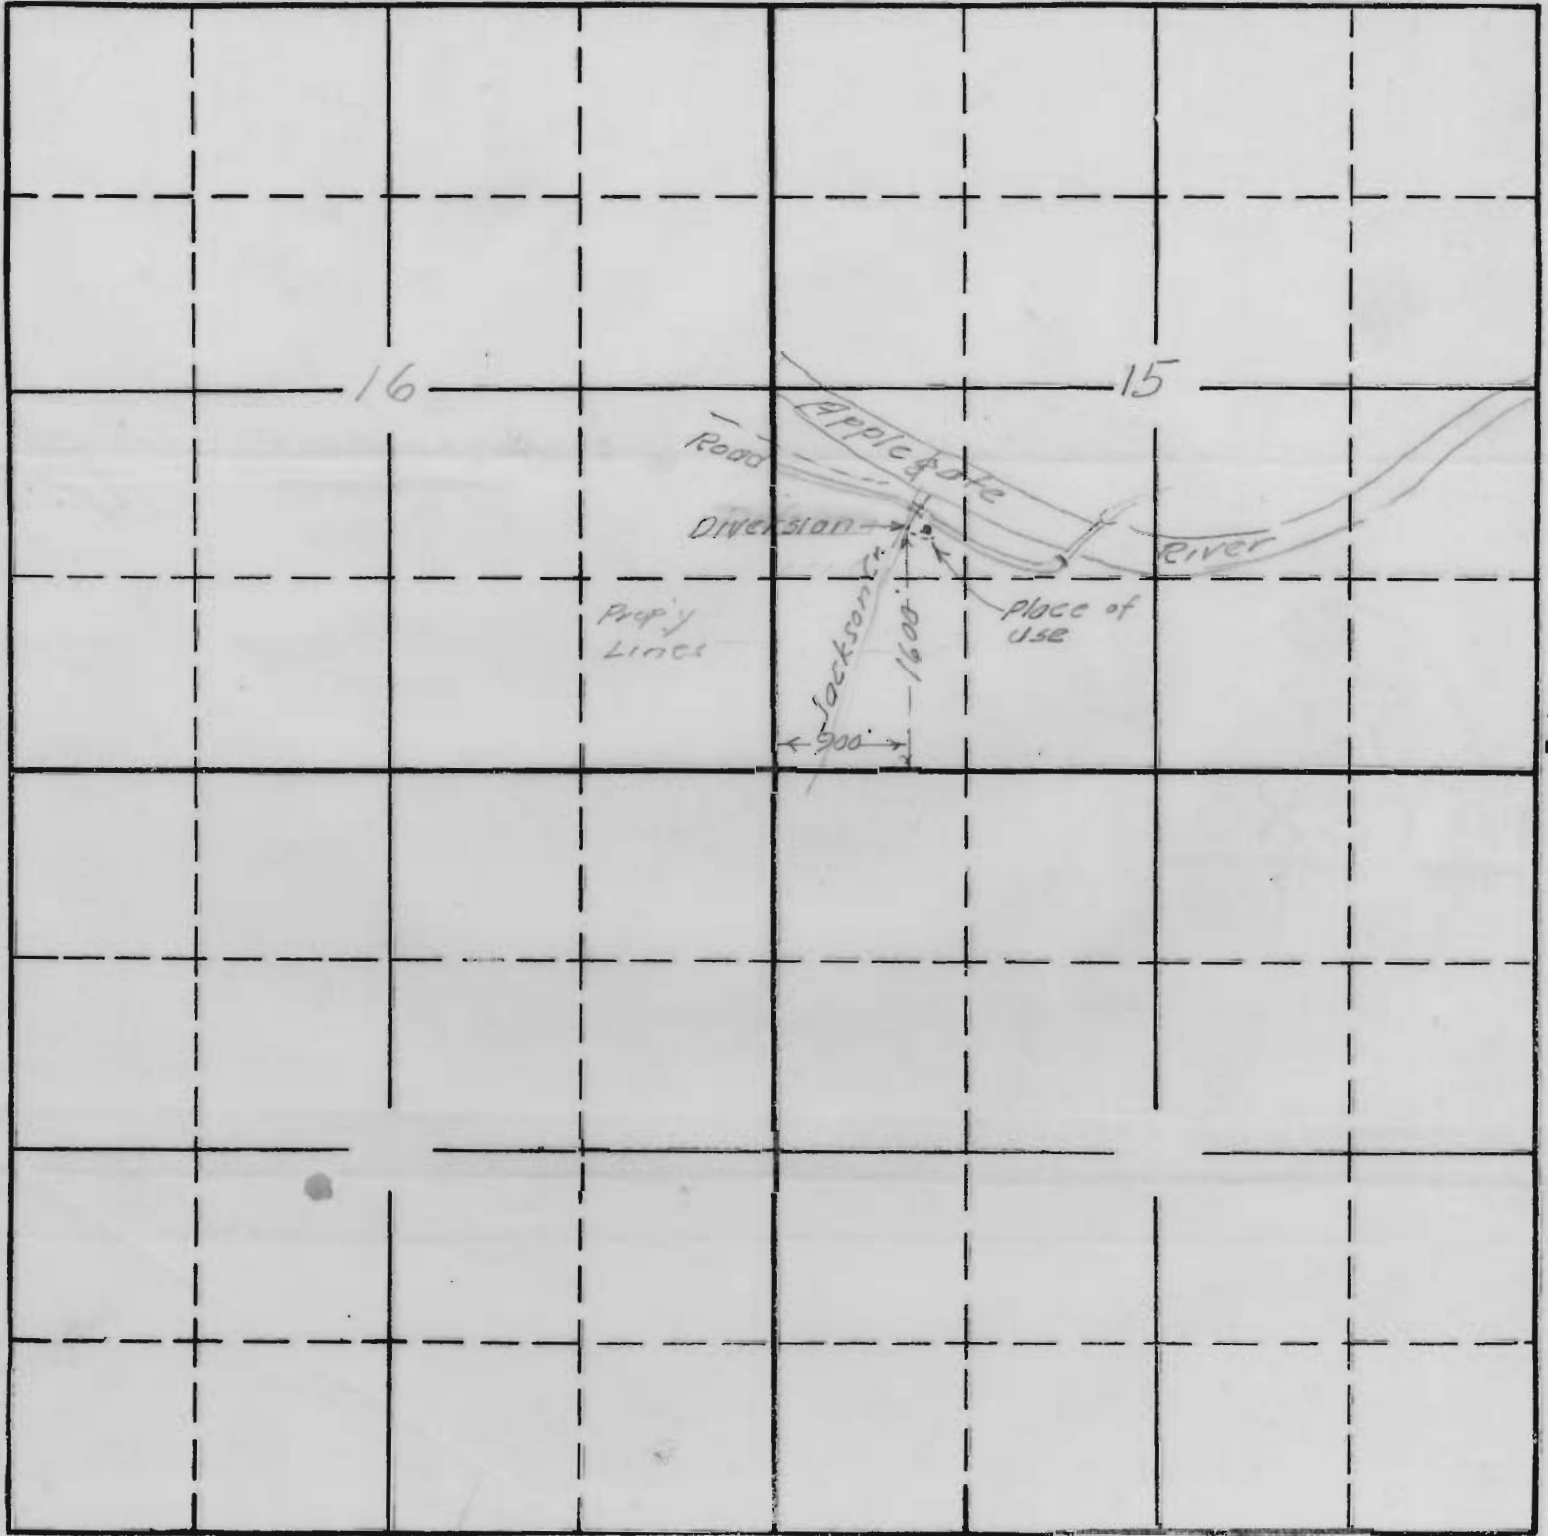

West

East

South

21740

15-160

RECEIVED

JUN 20 1946

STATE ENGINEER
SALEM, OREGON

APPLICATION No. 21740

PERMIT No. 17059