


33

TOWNSHIP 37 S, RANGE 2 W, W. M.

North

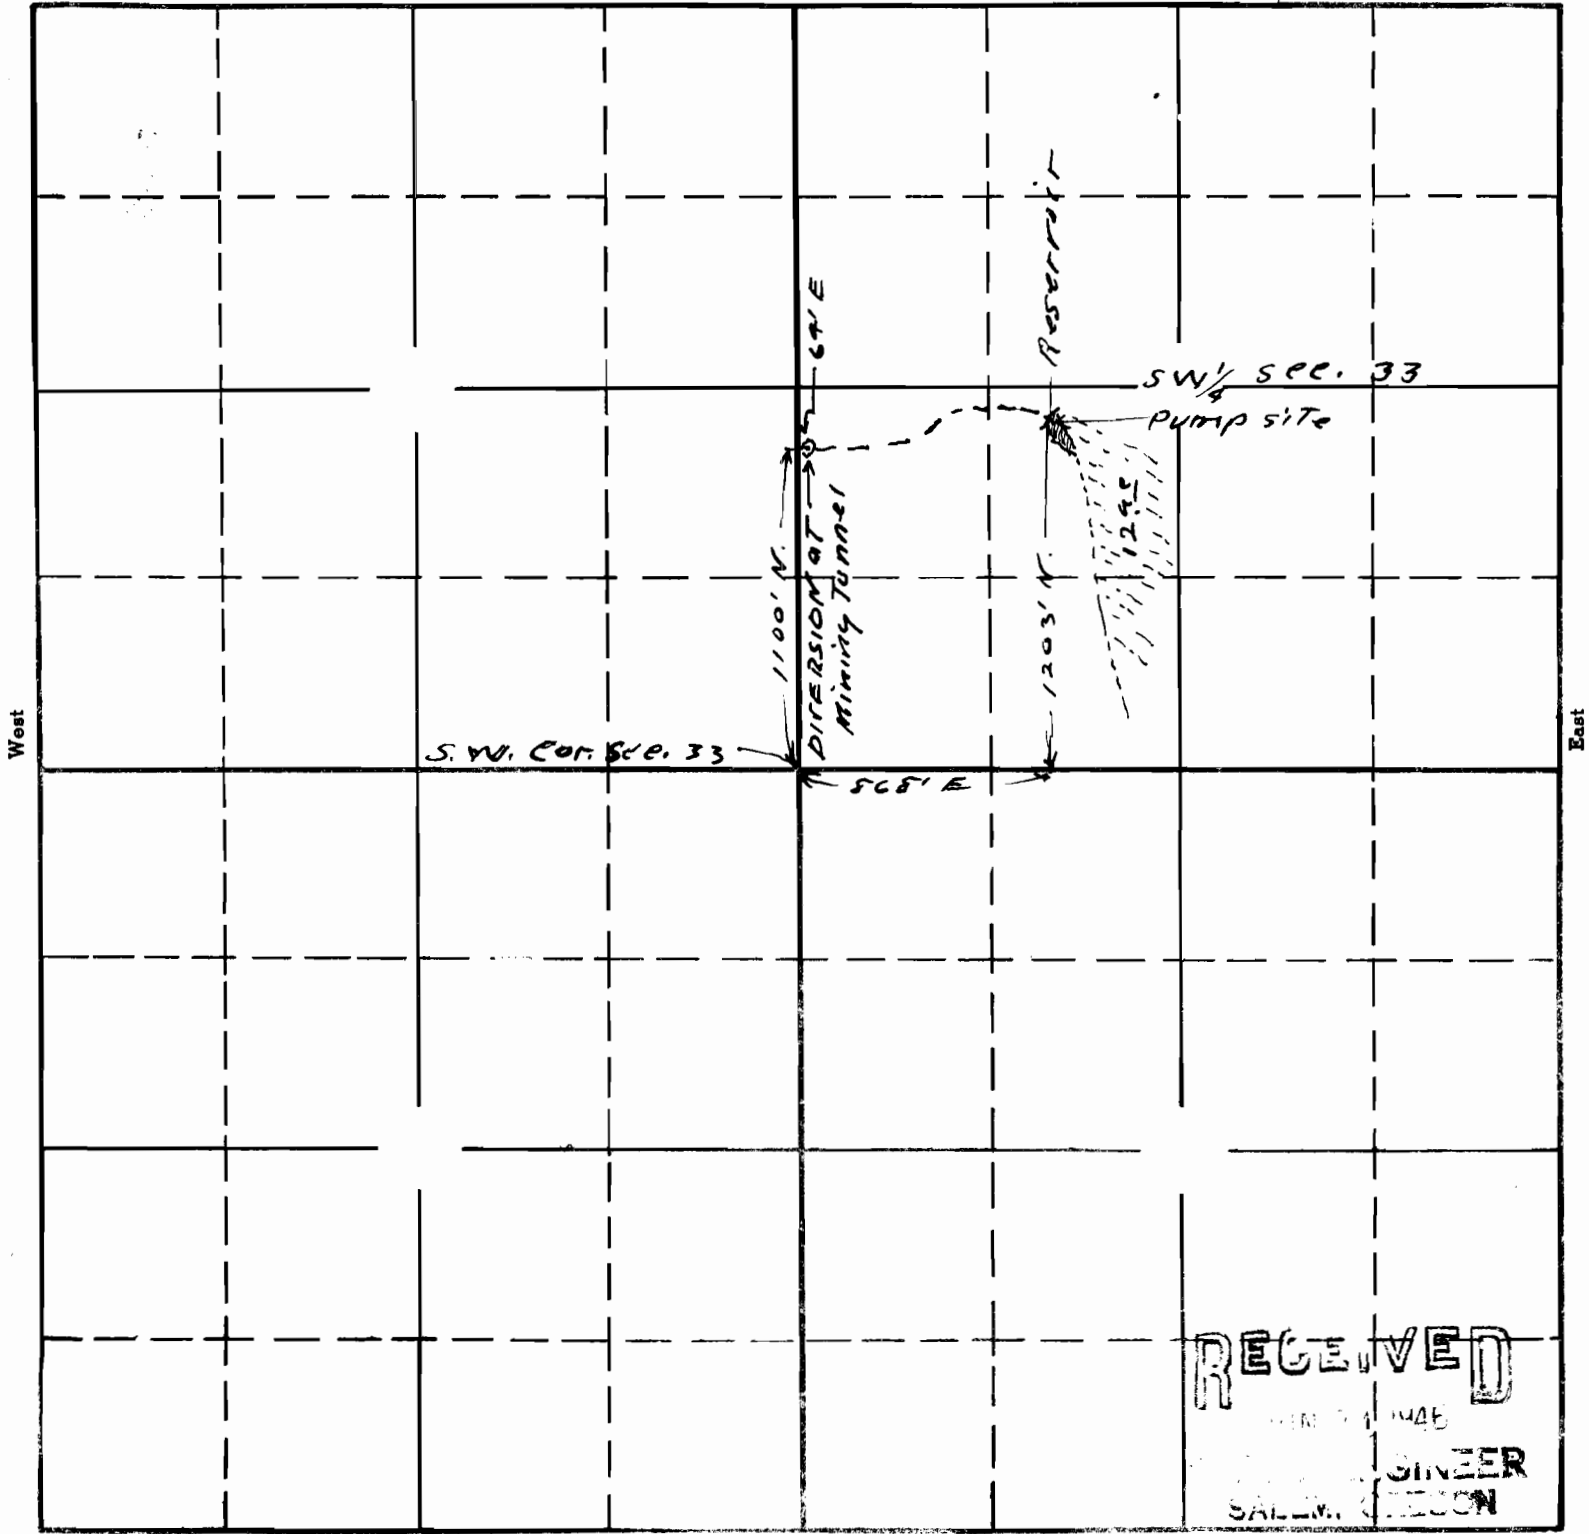

West

East

South

RECEIVED
 JUN 15 1946
 CIVIL ENGINEER
 SALEM, OREGON

21754

15-24

APPLICATION No. 21754

PERMIT No. 17066

Map to accompany application of
 Roy V Martin for use of waters
 from Martin Reservoir for
 irrigation purposes

This office 6/18/46 D.S.