


Sections

27 & 28

T. 13 S. R. 10 W. W.M.

North

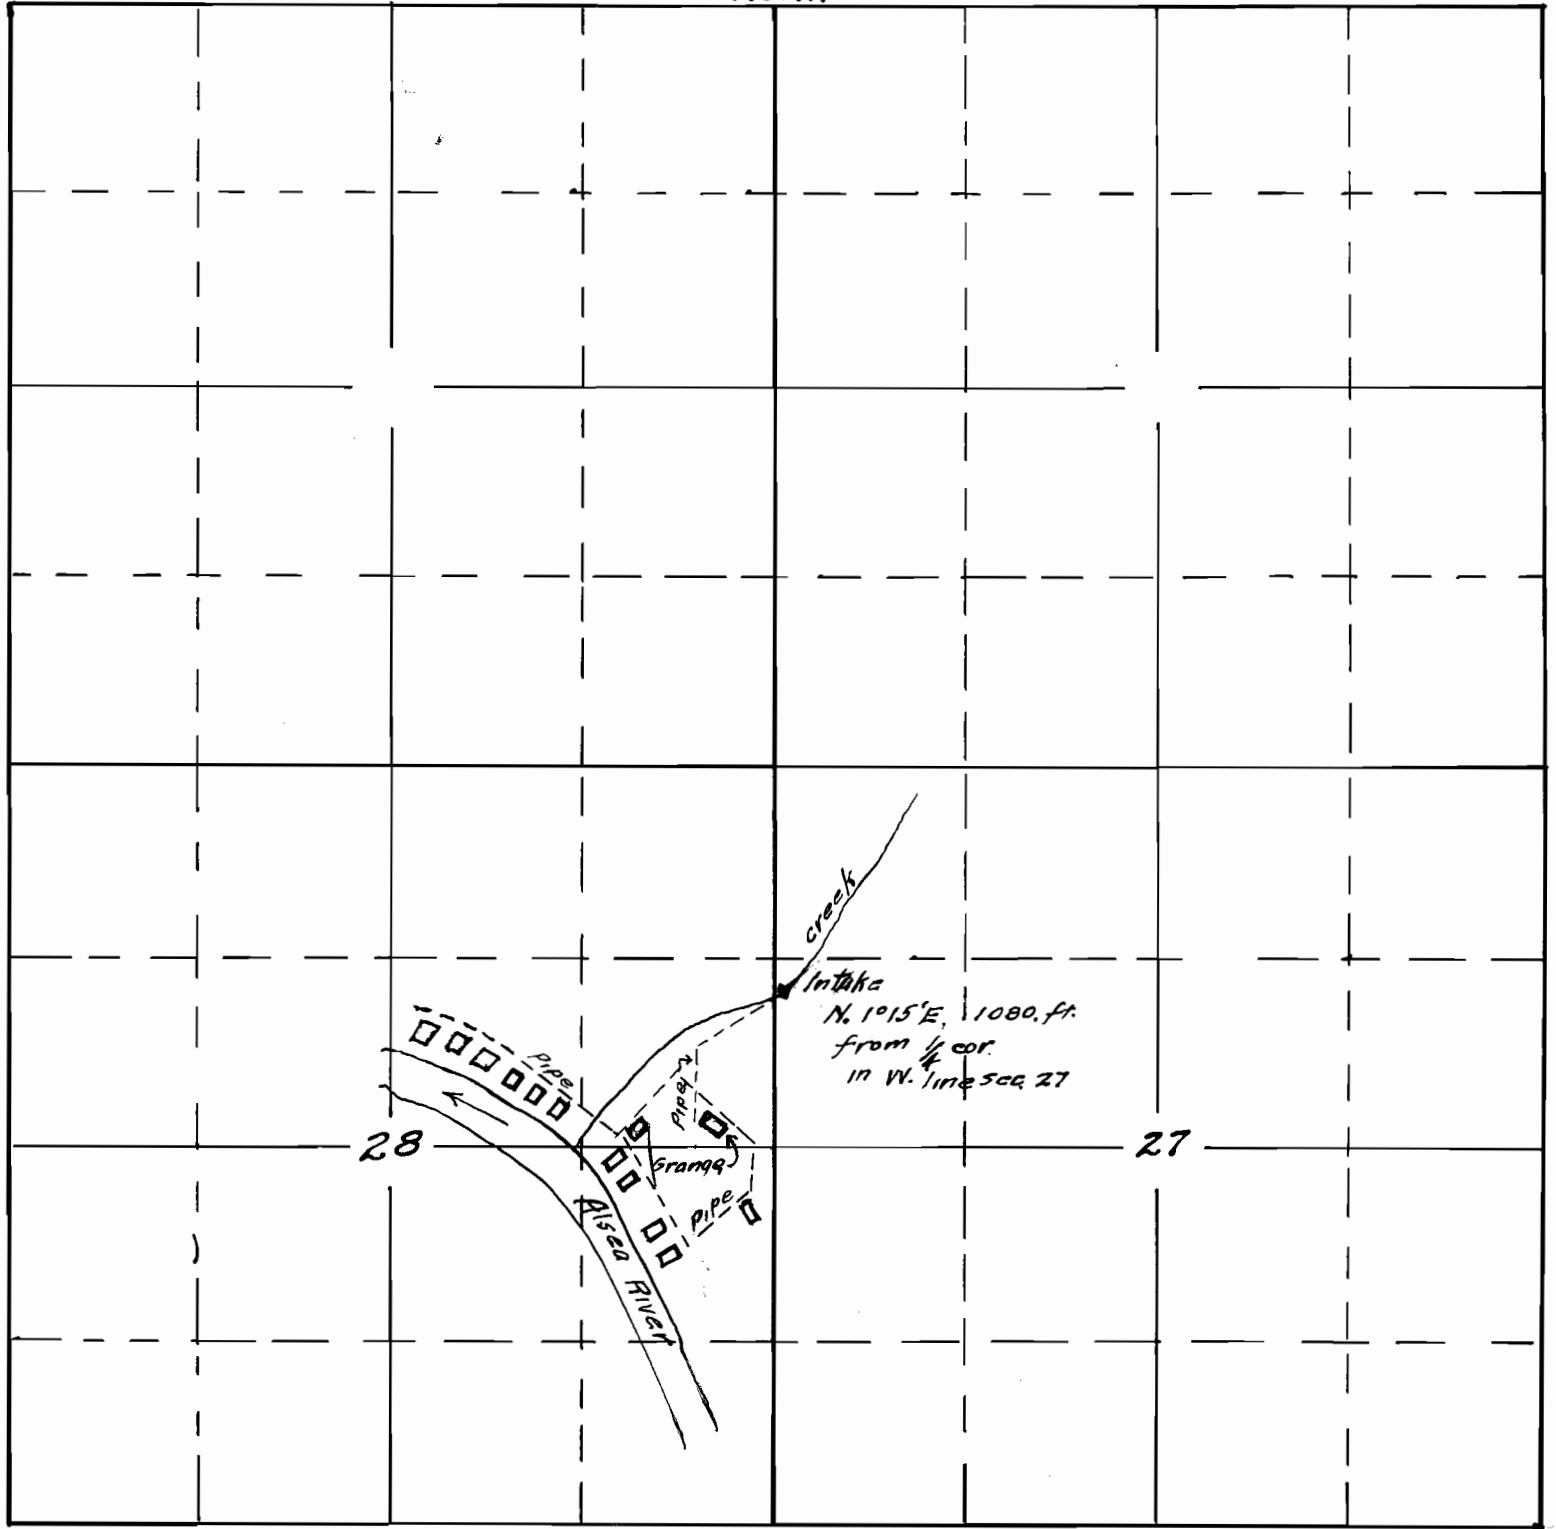

Application No. 21210
Permit No. 47071