


31

TOWNSHIP 36 S, RANGE 4 W, W. M.

North

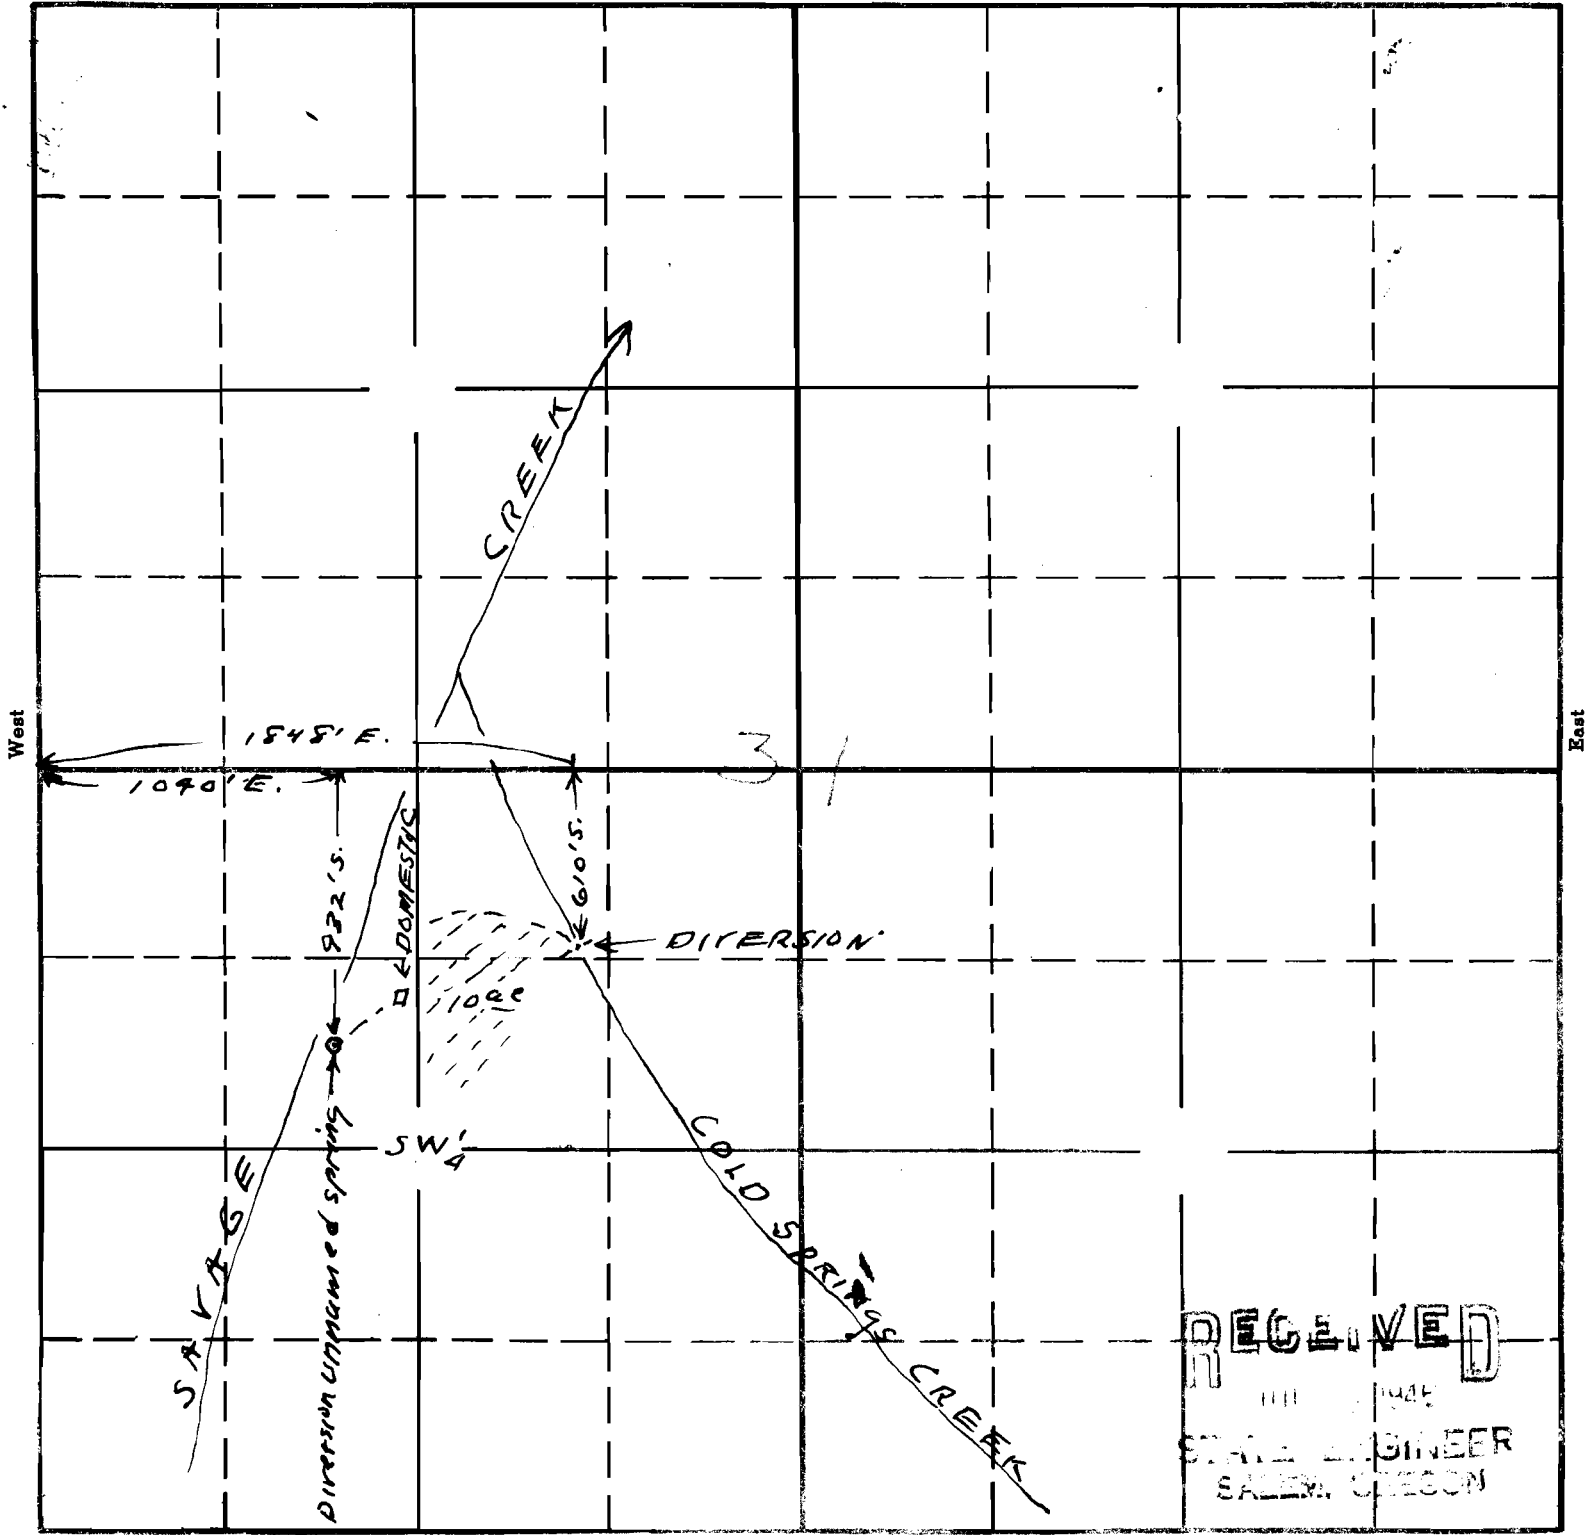

Map to accompany application of Charles Taylor for use of waters from Cold Spring Creek for irrigation & stock and from unnamed Spring for domestic use.

APPLICATION No. 21766  
 PERMIT No. 122

This office 6/24/46 *W. Smith*